

**Meeting of the Central Valley Flood Protection Board
January 28, 2011**

Staff Report – USACE Project Transfer

American River Common Features (Remaining Sites) WRDA 1996 Contract 1 (Site R4), Sacramento County

1.0 – ITEM

Consider approval of Resolution No. 10-45 to accept completed American River Common Features Project from the U.S. Army Corps of Engineers (USACE) and transfer operation and maintenance responsibility to the Sacramento Area Flood Control Agency (SAFCA).

2.0 – LOCATION

The project is located approximately 250 feet south of the Strong Ranch Pump Station and 1,330 feet northwest of the Northrop Avenue west terminus as measured along the American River Bike Trail in Sacramento County.

3.0 – DESCRIPTION

American River Common Features Project, as authorized by the Water Resources Development Act of 1996 (WRDA 1996), consists of strengthening of 8.9 miles of the right (north) bank and 10.6 miles of the left (south) bank of the American River levee, and 12.1 miles of the Sacramento River east levee and some berm raising. Eighteen "windows" were left during the initial construction of the slurry walls along the American River. These windows exist near bridge abutments, deep underground utility lines and under low overhead utility lines along both the right and left bank levees. These windows are designated with either an "L" for left bank and "R" for right bank. The subsequent number designates its ordered position relative to the other similar project locations. This turnover letter is for site R4 only.

The work associated with Site R4 includes the installation of a reinforced concrete drainage channel outlet wall keyed into the existing slurry wall.

4.0 – PROJECT ANALYSIS

4.1 – Project Background

1. The USACE, with DWR and SAFCA as local sponsors, completed construction at Site R4 on September 1, 2009. The project work was performed under a California Environmental Quality Act Categorical Exemption, filed April 14, 2008 (State Clearinghouse Number 2008048211).
2. The USACE sent a letter, dated July 1, 2010 (Attachment A), alerting the Board that it is transferring the recently completed portion of work (Site R4) performed under the authority of WRDA 1996 and providing a turnover package which included the amendments to the Operation and Maintenance Manual (Attachment B) and the As-Built Drawings (Attachment C).
3. SAFCA, in a letter dated January 19, 2011(Attachment D), notified the Board of the assurance of their acceptance of the completion of construction of Site R4, and its desire to accept operation and maintenance responsibility for said completed construction.

4.2 – Project Design Review

The project design and construction work was monitored by DWR staff throughout the project. The As-Built Drawings and the revisions to the Operation and Maintenance Manual were also reviewed by DWR staff.

The construction was completed in accordance with American River Common Features WRDA 1996 Remaining Sites Contract I (Site R4), Specification Number 1593, Design File Number 104-0514, Contract Number W91238-09-D-0020. As-Built Drawings and revisions to the Operation and Maintenance Manual are attached. Also, a copy of the "Written Notice of Acceptance of Completed Work" (Attachment E) is included as required by the Project Cooperation Agreement (PCA).

5.0 – STAFF RECOMMENDATION

Staff recommends that the Board adopt Resolution No. 10-45, which constitutes the Board's written findings and decision. The Resolution contains the following recommended actions:

1. Approves the acceptance of the completed American River Common Features (Remaining Sites) WRDA 1996 Contract 1 (Site R4) from the USACE and authorizes Board Staff to issue a letter to the USACE (Attachment F) informing them of the same.
2. Approves the transfer of the operation and maintenance responsibility of the completed American River Common Features (Remaining Sites) WRDA 1996 Contract 1 (Site R4) to SAFCA and authorizes Board Staff to issue a letter to SAFCA (Attachment G) informing them of the same.
3. Delegates to the Board Executive Officer the authority to sign the letters to the USACE and SAFCA.

5.0 – LIST OF ATTACHMENTS

- A. Resolution 10-45
- B. Transfer Letter from USACE (Dated July 1, 2010)
- C. Amendment to Operation and Maintenance Manual – American River Flood Control Project
- D. American River Common Features (Remaining Sites) WRDA 1996 Contract 1 (Site R4) – As-Built Drawings
- E. Letter from SAFCA accepting O&M responsibility for Site R4 (January 19, 2011)
- F. Written Notice of Acceptance of Completed Work
- G. Letter to be sent to USACE acknowledging transfer of Site R4 (Dated January 28, 2011)
- H. Letter to be sent to SAFCA transferring Operation and Maintenance responsibility to SAFCA (Dated January 28, 2011)

Design Review:	Jason Sidley
Environmental Review:	Environmental Staff Assigned
Document Review:	Kent Zenobia, Dan Fua

STATE OF CALIFORNIA
CALIFORNIA NATURAL RESOURCES AGENCY
THE CENTRAL VALLEY FLOOD PROTECTION BOARD

RESOLUTION NUMBER: 10-45

ACCEPTANCE OF AMERICAN RIVER COMMON FEATURES REMAINING SITES
CONTRACT 1 (SITE R4) FROM THE U.S. ARMY CORPS OF ENGINEERS AND
TRANSFER OPERATION AND MAINTENANCE RESPONSIBILITY TO THE
SACRAMENTO AREA FLOOD CONTROL AGENCY (SAFCA)

WHEREAS, the Central Valley Flood Protection Board (Board) has entered into a Project Cooperation Agreement with the United States Army Corps of Engineers (USACE), Contract Number B81560, dated 9/9/1998, to cost share funding for the American River Common Features Project; and

WHEREAS, the Board has entered into a Local Project Cooperation Agreement (LPCA) with SAFCA, Contract Number B81559/165946, dated 9/9/1998, to cost share funding for the local share of the American River Common Features Project; and

WHEREAS, the LPCA identified SAFCA as the Local Maintaining Agency (LMA) for the American River Common Features Project; and

WHEREAS, construction of Site R4 was completed by the USACE in accordance with American River Common Features Water Resources Development Act 1996 – Remaining Sites Contract 1, Specification Number 1593, Design File Number 1-04-0514, Contract Number W91238-09-D-0020; and

WHEREAS, the USACE, in a letter to the Board, dated July 1, 2010, has notified the Board of the completion of construction of Site R4, and its desire to turn over to the Board such work, as completed, for operation and maintenance; and

WHEREAS, the LPCA states that the Board shall turn completed projects from USACE over to SAFCA for operation and maintenance; and

WHEREAS, SAFCA, in a letter dated January 19, 2011, has notified the Board of the assurance of their acceptance of the completion of construction of Section R4, and their desire to accept operation and maintenance responsibility for said completed construction.

NOW, THEREFORE, LET IT BE RESOLVED that the Board:

1. Approves the acceptance of the completed American River Common Features (Remaining Sites) WRDA 1996 Contract 1 (Site R4) from the

USACE and authorizes Board Staff to issue a letter to the USACE informing them of the same.

2. Approves the transfer of the operation and maintenance responsibility of the completed American River Common Features (Remaining Sites) WRDA 1996 Contract 1 (Site R4) to SAFCA and authorizes Board Staff to issue a letter to SAFCA informing them of the same.
3. Delegates to the Board Executive Officer the authority to sign the letters to the USACE and SAFCA.

BY: _____

Benjamin F. Carter
President

Date: _____

BY: _____

Francis Hodgkins
Secretary

Date: _____

Approved as to Legal Form and Sufficiency

Jeremy Goldberg
Staff Counsel



REPLY TO
ATTENTION OF

DEPARTMENT OF THE ARMY
U.S. Army Engineer District, Sacramento
Corps of Engineers
1325 J Street
Sacramento, California 95814-2922

Flood Protection and Navigation Section

JUL 01 2010

Mr. Jay Punia, Executive Officer
Central Valley Flood Protection Board
3310 El Camino Avenue, Room 151
Sacramento, California 95821

Dear Mr. Punia:

This letter is to transfer the U.S. Army Corps of Engineers (Corps) recently completed portion of work (R4) performed under the authority of the Water Resources Development Act of 1996 (WRDA 96). American River (Common Features) as authorized by WRDA 96 consists of lower American River levee strengthening of 8.9 miles of the right (north) bank and 10.6 miles of the left (south) bank levees, and 12.1 miles of Sacramento River east levee and berm raising. Eighteen American River "windows" exist where construction of separate cutoff walls and appurtenant structures around bridge abutments, deep underground utility lines and under low overhead utility lines for both right and left bank levees are required to ensure complete closure of the slurry wall. These "windows" are designated with either an "L" for left bank and "R" for right bank. The subsequent number designates its ordered position relative to the other similar project locations. This turnover letter is for site R4 only.


Site R4 is located approximately 250-feet south the Strong Ranch Pump Station and 1,330-feet northwest of the Northrop Avenue west end terminus as measured along the American River Bike Trail. The R4 project includes a new reinforced concrete drainage channel outlet wall keyed into the slurry wall built under a previous contract.

The construction was completed in accordance with American River Common Features WRDA 1996 - Remaining Sites Contract 1, Specification Number 1593, Design File Number 1-04-0514, Contract Number W91238-09-D-0020. As constructed drawings and revisions to the Operation and Maintenance Manual are enclosed. Also, a copy of the "Written Notice of Acceptance of Completed Work" is included as required by the Project Cooperation Agreement (PCA). Both hard-copy and electronic versions (CD) are provided.

This work meets the requirements of the existing Operation and Maintenance Manual American River - Part No. 1, Levee Construction from Carmichael Bluffs Downstream 8.3 miles; therefore, said flood control work is transferred as of the date of this letter to the State of California for operation, maintenance, repair, replacement, and rehabilitation (OMRR&R). This letter of acceptance into the Federal flood control system should not be construed as an endorsement for inclusion into the National Flood Insurance Program as outlined in Title 44 of the Code of Federal Regulations Section 65.10 of the National Flood Insurance Regulations (44 CFR Section 65.10).

If you have any questions regarding this project, please contact the Project Manager, Mr. John Hoge, at (916) 557-53042. If you have any questions regarding this transfer, please contact Mr. Ryan Larson at (916) 557-7568, Flood Protection and Navigation Section. A copy of this letter is being furnished to Mr. Stein Buer, Sacramento Area Flood Control Agency, 1007 7th Street, Sacramento, CA 95814.

Sincerely,

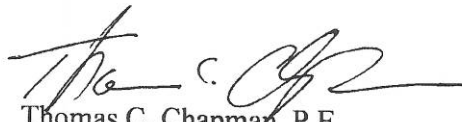A handwritten signature in black ink, appearing to read 'Th. C. Chapman', with a stylized flourish at the end.

Thomas C. Chapman, P.E.
Colonel, Corps of Engineers
District Engineer

Enclosures

**OPERATION AND MAINTENANCE
MANUAL
AMERICAN RIVER
FLOOD CONTROL PROJECT**

**AMERICAN RIVER – PART NO. 1
LEVEE CONSTRUCTION
FROM
CARMICHAEL BLUFFS DOWNSTREAM 8.3 MILES**

REVISIONS OR ADDITIONS

ADDITIONS		DATE
Exhibit F	Add copy of letter of transfer dated 17 Nov 1958	23 Mar 2010
Paragraph 4-05. a.(4)	Slurry Wall Facilities added	01 Jul 2010
Paragraph 4-05. a.(4)(a)	Site R4 added	01 Jul 2010
Paragraph 4-05. b.(5)	Site R4 added	01 Jul 2010
Exhibit F	Copy of R4 Transfer letter added	01 Jul 2010

REVISIONS		DATE
Paragraph 4-04. a.	Revised to include R4 structure	01 Jul 2010
Exhibit B	Revised to include R4 structure	01 Jul 2010

which become lodged against the bank shall be removed. The improved channel or floodway shall be thoroughly inspected immediately following each major high water period. As soon as practicable thereafter all snags and other debris shall be removed and all damage to walls, drainage outlets or other flood control structures repaired."

4-04. Drainage and Irrigation Structures.

a. Description. Drainage and irrigation structures which extend through the levees are listed as follows. **See drawing set 01-04-0415 for centerline stationing:**

Centerline Station	Bank	Size of Pipe	Other Structure Description	Elevation Invert of Pipe
33+55	Right	1-1/2"		60.6
37+58	"	1-1/2"		63.0
40+10	"	2-1/2"		-
42+25	"	1-1/2"		62.0
44+46	"	1-1/2"		63.0
48+75	"	1-1/2"		63.0
49+50	"	1-1/2"		63.7
51+50	"	1-1/2"		63.0
201+75	"	8"	Gate valve R.S. crown	55.0
203+45	"	3-24" C.	Pumping plant #2	40.0
203+45	"	24" C.	Pumping plant #2	30.0
224+30	"	10"		44.7
227+70	"	6"		43.4
288+65	"	8"	Gate valve R.S. crown	52.0
296+85	"	12"	Riser unit R.S. C.E.S.	40.0
346+09	"	12"	Riser unit R.S. C.E.S.	36.0
365+14	"	36"CM.	Riser unit R.S.	31.8
425+30	"	7-48"C.	Pumping plant No. 1	31.0
425+30	"	36"C.	Pumping plant No. 1	18.0
38°35.0514'N 121°25.2672'W (NAD 83)	"	23'± Total Width	1-Double Box Culvert and 1- Single Box Culvert Endwall and Apron [R4]	4.45± DBC 4.73± SBC NGVD 1929

Notes on abbreviations:

R.S.	=	Riverside
C.M.	=	Corrugated Metal
C.	=	Concrete
C.E.S.	=	Concrete Encased Steel Pipe
DBC	=	Double Box Culvert
SBC	=	Single Box Culvert

b. Inspection.

- (1) Pertinent Requirements of the Code of Federal Regulations.
Flood Control Regulations, paragraph 208.10 (d)(1), are quoted in part as follows:

whether seepage is taking place along the lines of their contact with the embankment. Immediate steps shall be taken to correct any adverse conditions."

- (2) The outlets of side drainage structures inundate at relatively low river stages. They should, therefore, be inspected at the first sign of a rise in the river to make certain that the gates are not jammed in an open position and thus allow flood waters to enter behind the levee.

4-05. Miscellaneous Facilities.

- a. Description. Miscellaneous structures or facilities which were constructed as a part of, or existed in conjunction with, the protective works, and which might affect their functioning, include the following:

- (1) Bridges.

- (a) A low water bridge crossing the American River at approximate centerline station 229+00. This bridge to be maintained by the owners at the adjacent rock plant.

- (b) The H Street bridge crossing the American River at approximate centerline station 364+00. This bridge to be maintained by the County of Sacramento.

- (2) Utility Relocations. Because of the nature of the construction of the levee by local interests, no records of any utility relocations are available.

- (3) Hydrographic Facilities. A continuous water stage recorder and staff gage located on the H Street Bridge. This station to be maintained by the U.S. Geological Society and the State Department of Water Resources.

- (4) Slurry Wall Facilities.

- (a) **Site R4: A reinforced concrete drainage channel outlet wall keyed into the slurry wall built under a previous contract, at approximate centerline station 422+70. The integrity of the structure/SCB (soil cement bentonite) cutoff wall interface is to be maintained by the Superintendent.**

- b. Inspection and Maintenance.

- (1) Pertinent Requirements of the Code of Federal Regulations. Flood Control Regulations, paragraph 208.10 (h)(1) are quoted in part as follows:

- (h) Miscellaneous Facilities. (1) Maintenance.
Miscellaneous structures and facilities constructed as a part of

the protective works and other structures and facilities which function as a part of, or affect the efficient functioning of the protective works, shall be periodically inspected by the Superintendant and appropriate maintenance measures taken. Damaged or unserviceable parts shall be replaced without delay...."

- (2) Inspection of the miscellaneous facilities shall be made at the same time that the inspection of the other features of the project are made, and shall be reported on check list No. 3, sheet No. 4 of Exhibit E.
- (3) The interest of the Corps of Engineers and the responsibility of the local interests in the existing highway and railroad bridges is confined to their effect on the safety and functioning of the flood control channel, but any conditions noted in the inspections that may affect them in any way should, as a matter of courtesy, be brought to the attention of the agencies maintaining and operating them. If the inspection of any miscellaneous structure, either existent or constructed in the future under permit, discloses any condition that indicates the probability of failure during periods of high water, the Superintendent shall address a letter to the owner of the structure, quoting this manual as authority and inviting attention to the conditions observed and requesting that immediate steps be taken to correct them. A copy of such letter shall be forwarded to the District Engineer for his information. A report of the action taken by the owner shall be submitted to the District Engineer to accompany the next semi-annual report. A suggested report form is included as EXHIBIT D of this manual.
- (4) The purpose of maintenance work is to insure continuous satisfactory operation of equipment. It is, therefore, important in such work that all possible causes of future trouble be found and corrected. Particular attention should be given to minor weaknesses which may be given to minor weaknesses which may be an indication of future trouble.
- (5) **Site R4: Modification or repair work in the vicinity of the concrete liner where the SCB cutoff wall is located should include provisions to avoid damaging the SCB cutoff. Work that requires penetrating the cutoff wall would require special consideration to assure that the cutoff wall forms a continuous seepage barrier as originally designed.**

Acceptable seepage barrier earth fill would have at least 30 percent fines (percent passing the No. 200 sieve) with liquid limit less than or equal to 45 and plasticity index of greater than 7 and less than 25. The controlled low strength material replacing the cutoff wall material should have a permeability similar to the

cutoff wall with at least 1×10^{-6} cm/sec permeability at 28 days and a strength of at least 40 psi at 28 days. Any potential impact to the cutoff shall be coordinated with the Corps of Engineers, Sacramento District to develop mitigation measures or repair methods for the cutoff wall.

Any channel modifications or repairs impacting the impervious blanket that starts at the SCB cutoff and extends to the levee slope shall be restored to the original layer thickness, using the same soil material type. Any repair to the concrete lined channel that affects the geomembrane and that connects the concrete liner edge to the impervious blanket shall be restored.

c. Operation.

- (1) Requirements of the Code of Federal Regulations. Flood Control Regulations, paragraph 208.10(h)(2) is quoted as follows:

“(2) Operation. Miscellaneous facilities shall be operated to prevent or reduce flooding during periods of high water. Those facilities constructed as a part of the protective works shall not be used for purposes other than flood protection without approval of the District Engineer unless designed therefore.”

Exhibit B

"AS CONSTRUCTED"
DRAWINGS

(See Separate Folder for the Following Drawings)

<u>FILE NO.</u>	<u>TITLE</u>
1-4-375	Emergency Levee Repairs and Bank Protection North Levee American River 1.3 Miles above H Street Bridge, Sheets 1 to 3, inclusive.
1-4-415	Levee Construction and Bank Protection, Fair Grounds to Carmichael Bluffs, Sheets 1 to 20 inclusive.
1-04-0514	American River Common Features (Remaining Sites) WRDA 1996 Contract 1, Sheets 1 to 21 inclusive. [Site R4]

EXHIBIT B
Unattached



US Army Corps
of Engineers
Sacramento District

AMERICAN RIVER COMMON FEATURES
(REMAINING SITES) WRDA 1996
CONTRACT 1
SACRAMENTO COUNTY
CALIFORNIA

FY 2009

AS BUILT

CONTR. NO: W91238-09-D-0020

This project was designed by the Sacramento District of the U. S. Army Corps of Engineers. The initials or signatures and registration designations of individuals appear on these project documents within the scope of their employment as required by ER 1110-1-8152


Approved
/S/KEVIN KNUJITL XX/XX/XX
Chief, Engineering Division Date:
Prepared Under the Direction of
/S/CDL. THOMAS C. CHAPMAN
Col. Corps of Engineers District Engineer

Drawing Code:
Designed by
P. HSLA
Spec No. 1593
Drawn by
D. MAYO
Design File No:
1-04-514

Approved Functional Adequacy
/S/RICK POEPPLEMAN XX/XX/XX
Chief, Design Branch Date:
Prepared by
SACRAMENTO DISTRICT
DESIGN BRANCH
/S/RICHARD A. TORBIK XX/XX/XX
Chief, Civil Design Sec B Date:

SACRAMENTO COUNTY CALIFORNIA
AMERICAN RIVER COMMON FEATURES
(REMAINING SITES) WRDA 1996
CONTRACT 1
SITE R4
TITLE COVER SHEET

Sheet
reference
number:
G-001
Sheet 1 of 21

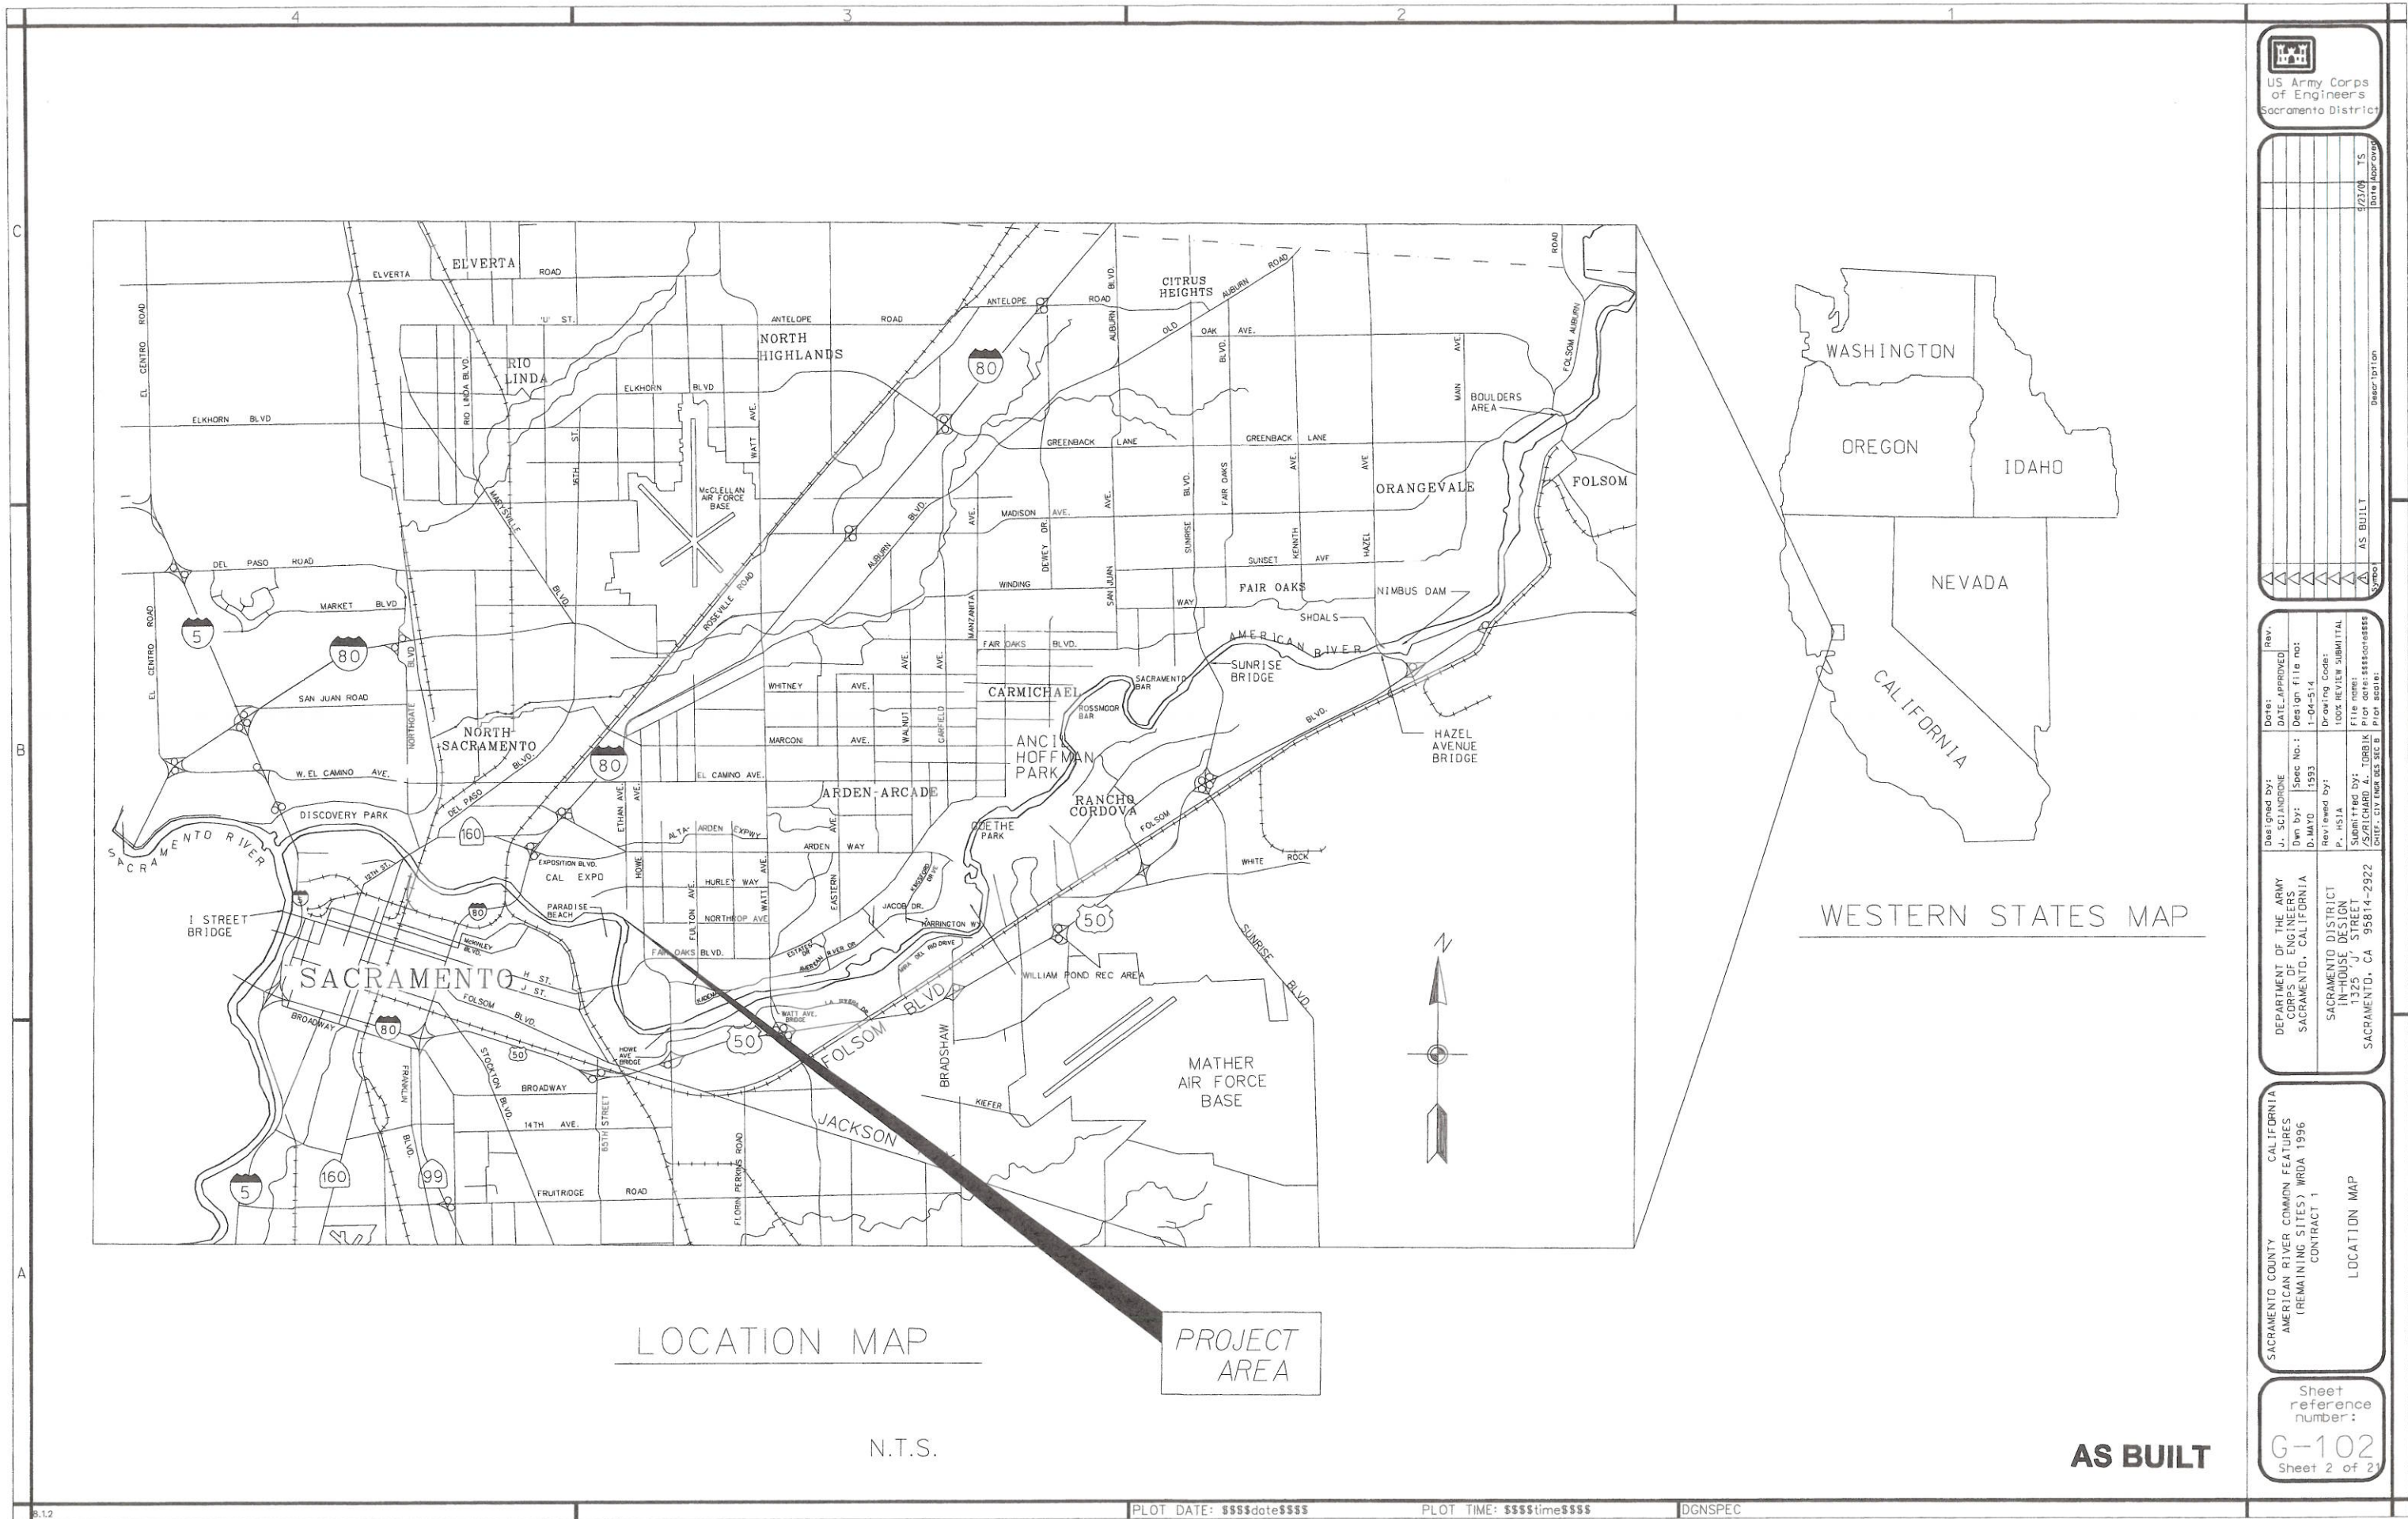

US Army Corps
of Engineers
Sacramento District

9/23/09	TS
AS BUILT	Date Approved

Designed by: J. SCANDONE	Date: DATE APPROVED	Rev.
Drawn by: D. MAYO	Design file no: 1-04-514	
Reviewed by: P. HSLA	Spec No.: 1593	
Submitted by: S/RICHARD A. TORBIAK	Drawing Code: 100% REVIEW SUBMITTAL	
Chief: C. J. G. DES SEC B	File name: PLOT DATE: 9/23/09	

SACRAMENTO COUNTY
CALIFORNIA
AMERICAN RIVER COMMON FEATURES
(REMAINING SITES) WRDA 1996
CONTRACT 1
LOCATION MAP

Sheet
reference
number:
G-102
Sheet 2 of 2

SCHEDULE OF DRAWINGS

SCHEDULE OF DRAWINGS		
GENERAL , CIVIL PLANS, BORING LOGS AND STRUCTURAL PLANS		
SHEET NO.	SHEET REFER NO.	SHEET TITLE
1	G-001	TITLE COVER SHEET
2	G-102	LOCATION MAP
3	G-603	SCHEDULE OF DRAWINGS
4	G-004	GENERAL NOTES, CONSTRUCTION NOTES, LEGENDS AND ABBREVIATIONS
5	G-105	ACCESS ROUTE, HAULING AND BIKE DETOUR PLAN
6	B-701	LOG OF EXPLORATION, 2F-03-15
7	B-702	LOG OF EXPLORATION, 2F-03-16
8	B-703	LOG OF EXPLORATION, 2F-97-13
9	B-704	LOG OF EXPLORATION, 2F-03-20
10	C-100	SITE PLAN
11	C-101	TOPOGRAHICAL SURVEY AND BIKE TRAIL DETAILS
12	C-102	GRADING PLAN AND PROFILE
13	C-103	STAFF GAUGE
14	C-104	TEMPORARY SHORING AND EXCAVATION PLAN
15	S-100	PLAN AND PROFILE
16	S-101	DEMOLITION PLAN
17	S-102	PLAN AND SECTION
18	S-103	SECTION AND DETAILS
19	S-104	SECTION AND DETAILS
20	S-105	IMPERVIOUS BLANKET AND CONNECTION DETAILS
21	S-106	GENERAL STRUCTURAL NOTES AND DETAILS

AS BUILT

Sheet
reference
number:
G-603
Sheet 3 of 21

SACRAMENTO COUNTY CALIFORNIA
AMERICAN RIVER COMMON FEATURES
(REMAINING SITES) WRDA 1996
CONTRACT 1


SCHEDULE OF DRAWINGS

DEPARTMENT OF THE ARMY CORPS OF ENGINEERS SACRAMENTO, CALIFORNIA	Designed by: J. SCIANORONE Dwn by: D.MAYO	Date: DATE APPROVED Design File no: 1-04-514	Reviewed by: P. HSIA Submitted by: S/SRICHARD A. TORRES 1325 STREET SACRAMENTO, CA 95814-2922	Drawing: 100% REVIEW SUBMITTAL File name: S/SRICHARD A. TORRES PLOT: 80101 CHIEF, CIV ENGR RES SEC II
--	--	---	---	--
















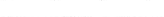






[illegible]

US Army Corps
of Engineers
Sacramento District

GENERAL NOTES

1.  DETAIL NUMBER
SHEET SHOWN
SHEET TAKEN
2. GENERAL NOTES ARE APPLICABLE TO ALL WORK, UNLESS NOTED OTHERWISE ON OTHER SHEETS.
3. BENCH MARK USED: SEE SHEET C-101

LEGENDS

	ELECTRICAL TOWER		OVERHEAD POWER/TELEPHONE LINES
	POWER POLE		GAS LINES
	ELECTRICAL VAULT		OVERHEAD POWER LINE
	TRANSFORMER UNDERGROUND		TELEPHONE LINE
	OVERHEAD SWITCH		SEWER LINE
	CATCH BASIN		STORM DRAIN
	SANITARY SEWER MANHOLE		WATER LINE
	RISER		CHAIN LINK OR OTHER TYPE FENCE
	STORM DRAIN MANHOLE		RIGHT-OF-WAY
	SOIL LOG LOCATION		LIMIT OF WORK
	SPOT ELEVATION		
	FINISH ELEVATION		

ABBREVIATIONS

AC	ASPHALT CONCRETE
AB	AGGREGATE BASE
AGP	ABOVE GROUND POWER
B.W.	BARBED WIRE
C.L.	CHAIN LINK
CL	CHAIN LINK
CJ	CONSTRUCTION JOINT
CLSM	CONTROLLED LOW STRENGTH MATERIAL
CM	CENTIMETER
CONC.	CONCRETE
DBL	DOUBLE
DEMO.	DEMOLISH
EL.	ELEVATION
EVT	EVENT POINT
EXIST.	EXISTING
FL	FLOW LINE
FT	FEET
IN	INCHES
L	LENGTH
M	METER
MIN	MINIMUM
N.T.S.	NOT TO SCALE
PGB	POINT OF BEGINNING
PCC	POINT OF COMPOUND CURVE
PC	POINT OF CURVE
POE	POINT OF ENDING
PI	POINT OF INTERSECTION
PT	POINT OF TANGENT
PVI	POINT OF VERTICAL INTERSECTION
R/W	RIGHT-OF-WAY
RFT	STEEL REINFORCEMENT
SD	STORM DRAIN
SLP	SLOPE
STA.	STATION
TYP	TYPICAL
TOC	TOP OF CONCRETE
TOGC	TOP OF GROUTED COBBLE
3H:1V	SLOPE OF 3 HORIZONTAL TO 1 VERTICAL

CONSTRUCTION NOTES

1. THE LOCATION OF EXISTING UTILITIES ARE SHOWN IN AN APPROXIMATE WAY ONLY AND HAVE NOT BEEN INDEPENDENTLY VERIFIED BY THE OWNER OR ITS REPRESENTATIVE. THE CONTRACTOR SHALL DETERMINE THE EXACT LOCATION OF ALL UTILITIES WITHIN THE CONSTRUCTION ZONE, ALONG THE CONSTRUCTION ACCESS ROUTE AND IN THE STAGING AREAS BEFORE COMMENCING WORK. THE CONTRACTOR SHALL BE FULLY RESPONSIBLE FOR ANY AND ALL DAMAGES WHICH MIGHT BE CAUSED BY THE CONTRACTOR'S FAILURE TO EXACTLY LOCATE AND PRESERVE ANY AND ALL UTILITIES.
2. CONTRACTOR SHALL NOTIFY THE CORPS OF ENGINEERS CONTRACTING OFFICER OF HIS CONSTRUCTION SCHEDULE IN ADVANCE OF CONSTRUCTION.
3. THE CONTRACTOR WILL BE RESPONSIBLE FOR:
- a) DISPOSAL OF EXCESS CONSTRUCTION AND EXCAVATION MATERIAL AND COMPLIANCE WITH ALL APPLICABLE FEDERAL, STATE, AND LOCAL REGULATIONS SUCH AS THE CLEAN WATER ACT AND THE NATIONAL HISTORIC PRESERVATION ACT.
- b) PREVENT ANY MATERIALS FROM ENTERING THE RIVER AT WATERSIDE DURING CONSTRUCTION.
- c) NO REFUELING OF MOBILE EQUIPMENT IS PERMITTED ON THE WATERSIDE OF THE LEVEE.
4. THE CONTRACTOR SHALL BE RESPONSIBLE FOR REPAIRING ANY DAMAGE CAUSED BY THE CONTRACTOR TO THE RECREATION BIKE TRAIL, STAGING AREAS, PAVEMENT, ROADS, FENCES, FLOOD CONTROL STRUCTURES, INCLUDING LEVEES, LEVEE RAMP, AND EXISTING BANK PROTECTION IMPROVEMENTS, VEGETATION, AND ALL OTHER UTILITIES AND IMPROVEMENT NOT DESIGNATED FOR REMOVAL.
5. EXISTING ROADWAYS SHALL BE KEPT CLEAR OF MUD AND DEBRIS AT ALL TIMES.
6. CONTRACTOR SHALL PROTECT IN PLACE ALL UTILITIES TO REMAIN WITHIN PROJECT LIMITS, AND WILL BE RESPONSIBLE FOR ANY DAMAGE TO THESE UTILITIES BY CONTRACT WORK. UTILITY SERVICES AND THEIR LOCATIONS MAY NOT BE COMPLETE AS SHOWN ON DRAWING PLANS. THE CONTRACTOR SHALL TAKE NECESSARY MEASURES TO LOCATE AND PROTECT SERVICES DURING CONSTRUCTION. CONTRACTOR SHALL NOT INTERRUPT ANY UTILITY SERVICES.
7. ACCESS TO THE LEVEE CROWN AND ACCESS RAMPS ARE INDICATED ON THE DRAWINGS UNLESS OTHERWISE APPROVED BY THE CONTRACTING OFFICER.
8. ELEVATIONS REFER TO NATIONAL GEODITIC VERTICAL DATUM (NGVD) 1929.
9. GRID COORDINATES REFER TO CALIFORNIA COORDINATE SYSTEM ZONE 11 NAD 83/91 AND ARE BASE ON THE CALIFORNIA H.A.R.N. PUBLISHED BY CAL-TRANS.

POINTS OF CONTACT

CONTACT INFORMATION IS PROVIDED FOR THE CONVENIENCE OF THE CONTRACTOR WHERE DIRECT CONTACT IS OR MAY BE REQUIRED. THE PRIMARY POINT OF CONTACT IS THE CONTRACTING OFFICER OR HIS/HER DESIGNATED REPRESENTATIVE. ONLY THE CONTRACTING OFFICER HAS THE AUTHORITY TO ALTER OR INTERPRET THIS CONTRACT SHOULD ANY INTERPRETATION BE NECESSARY. IN THE EVENT ANY CONTACT, WHETHER LISTED HERE OR NOT REQUESTS ADDITIONAL WORK OR AN ALTERATION OF THIS CONTRACT, THE CONTRACTOR SHALL INFORM THE CONTRACTING OFFICER AS SOON AS POSSIBLE, WITH WRITTEN FOLLOW-UP, AND BEFORE PLANNING ANY SUCH WORK.

USA (UNDERGROUND SERVICE ALERT)
1 800 227 2600

SMUD
Al Sanders inspector
916 869 0510

SACRAMENTO COUNTY TRAFFIC CONTROL
(permit needed for hauling material and routing)
PRIMARY:
JACKIE GROOVER
827 SEVENTH STREET
ROOM 105 WINDOW 11
SACRAMENTO, CA 95814
916 874 5606
SECONDARY:
SCOTT URBANIK
4100 TRAFFIC WAY
SACRAMENTO, CA 95827
urbaniks@sacounty.net

AMERICAN RIVER FLOOD CONTROL DISTRICT
(entity which will operate and maintain levee when complete)
TIM KERR, GENERAL MANAGER, 165 COMMERCE CIRCLE,
SUITE D, SACRAMENTO, CA 95815
VOICE 916 929 4006
CELL 916 417 4161
FAX 916 929 4160

Sacramento County Regional Parks
(managing entity of area from fence to river)
4040 Bradshaw Road,
Sacramento, CA 95827
PRIMARY:
STEVE FLANNERYCHIEF RANGER
916 876 5405
flannerys@sacounty.net
SECONDARY:
MARY MARET
916 875 4918
maret@sacounty.net
FAX 916 201 5691

SACRAMENTO COUNTY
WATER RESOURCES DEPARTMENT
STEPHEN KENNING (PRIMARY)
3847 BRANCH CENTER ROAD
SACRAMENTO, CA 95827
916 875 7142
petersont@sacounty.net
MIKE CROOKS (ALTERNATE)
9280 W. STOCKTON BLVD. #220
ELK GROVE, CA 95753
916 874-5180
crooksm@sacounty.net

SACRAMENTO REGIONAL COUNTY SANITATION DISTRICT)
PRIMARY: STEVE NORRIS
10545 ARMSTRONG AVE, SUITE 101
MATHER, CA 95655
916 876 6053
norriss@sacounty.NET
SECONDARY: MELENIE DAVIS
COUNTY SANITATION DISTRICT 1

SACRAMENTO METRO FIRE DISTRICT
EMERGENCY ALWAYS CALL 911
PRIMARY
Michael Keehn, Fire Prevention Bureau
Supervising Inspector
office: 942-3326 cell: 616-4679
keehn.michael@smfd.ca.gov
SECONDARY
Deputy Chief of Operations Geoff Miller:
566-4303
miller.geoffrey@smfd.ca.gov
TERTIARYAssistant Chief of Operations Mike Johnson:
566-4307
johnson.mike@smfd.ca.gov



Date	Rev.	Description
1/23/09	TS	AS BUILT

Designated by:	Date:	Rev.
J. SCIANDRONE	DATE APPROVED	
D. MAYO	Design file no:	
	1-04-514	
	Spec No.:	
	1593	
	Drawing Code:	
	100% REVIEW SUBMITTAL	
	File name:	
	ASBUILT-000000000000	
	Plot date:	
	Plot scale:	

SACRAMENTO COUNTY CALIFORNIA AMERICAN RIVER COMMON FEATURES (REMAINING SITES) WRDA 1996 CONTRACT 1 GENERAL NOTES, CONSTRUCTION NOTES LEGENDS, ABBREVIATIONS AND POINTS OF CONTACT
--

Sheet
reference
number:
G-004
Sheet 4 of 21

AS BUILT



Rev.	Date	By	Description
1	1 MAY 2007	AS BUILT	AS BUILT

Designed by J. SCHWAB	Checked by K. PLAN	Reviewed by R. HANSA	Approved by J. SCHWAB
DATE: 1 MAY 2007	DATE: 1 MAY 2007	DATE: 1 MAY 2007	DATE: 1 MAY 2007

SACRAMENTO COUNTY AMERICAN RIVER COMMON FEATURES CONTRACT 1 SITE - R4 LOG OF EXPLORATION 2F-97-13
--

Sheet reference number: B-703 Sheet 8 of 21

STANDARD PENETROMETER DESCRIPTIVE DATA

COHESIONLESS		COHESIVE	
BLOWS*	RELATIVE DENSITY	BLOWS*	CONSISTENCY
0-4	VERY LOOSE	0-1	VERY SOFT
5-10	LOOSE	2-4	SOFT
11-20	FIRM	5-8	FIRM
21-30	VERY FIRM	9-15	STIFF
31-50	DENSE	16-30	VERY STIFF
51+	VERY DENSE	31+	HARD


*BLOWS PER 0.3m OF PENETRATION OF A 51mm O.D. AND 35mm I.D. SAMPLER DRIVEN BY A 63.5kg HAMMER, WITH A 0.76m FREEFALL.

LEGEND:

- GR GRAVEL, PERCENT BY WEIGHT PASSING THE 76mm (3-INCH) SIEVE AND RETAINED ON THE NO. 4 SIEVE.
- SA SAND, PERCENT BY WEIGHT PASSING THE NO. 4 SIEVE AND RETAINED ON THE NO. 200 SIEVE.
- FI FINES, PERCENT BY WEIGHT PASSING THE NO. 200 SIEVE.
- LL LIQUID LIMIT.
- PI PLASTICITY INDEX (LIQUID LIMIT MINUS PLASTIC LIMIT).
- MC LABORATORY DETERMINED MOISTURE CONTENT IN PERCENT OF DRY WEIGHT.
- SM COMBINED FIELD VISUAL IDENTIFICATION AND/OR LABORATORY CLASSIFICATION.
- NP NONPLASTIC.
- N NUMBER OF BLOWS WITH THE STANDARD PENETROMETER.
- N* NUMBER OF BLOWS WITH SAMPLERS LARGER THAN THE STANDARD PENETROMETER.
- R REFUSAL WITH THE STANDARD PENETROMETER (SEE NOTE 10).
- A ATTEMPT WITH THE STANDARD PENETROMETER (SEE NOTE 11).
- WATER LEVEL.
- B.O.H. BOTTOM OF HOLE.

NOTES:

- THIS DRAWING IS TO BE USED ONLY FOR APPROXIMATE DESCRIPTIONS OF SUBSURFACE CONDITIONS.
- SOIL CLASSIFICATIONS AND DESCRIPTIONS ARE BASED ON FIELD LOG DESCRIPTIONS IN ACCORDANCE WITH ASTM D 2488 (DESCRIPTION AND IDENTIFICATION OF SOILS, VISUAL-MANUAL PROCEDURE) AND/OR LABORATORY TEST RESULTS IN ACCORDANCE WITH ASTM D 2487 (CLASSIFICATION OF SOILS FOR ENGINEERING PURPOSES).
- ALL COLORS SHOWN ARE IN ACCORDANCE WITH THE MUNSSELL SOIL COLOR CHART.
- ALL SIEVE SIZES SHOWN ARE METRIC WITH U.S. STANDARD IN PARENTHESES.
- BORING 2F-97-13 WAS DRILLED WITH A CME 75 DRILL RIG USING A 203mm (8") HOLLOW STEM AUGER BETWEEN 8 AND 11 AUGUST 1997.
- WHERE COBBLES WERE ENCOUNTERED, LABORATORY GRADATION DATA REPRESENT MATERIAL PASSING THE 76mm (3") SIEVE. RECOVERY OF PARTICLES LARGER THAN THE INSIDE DIAMETER OF THE SAMPLER WERE NOT RECOVERED; HENCE, ALL GRAVEL AND COBBLE LAYERS REFERENCED IN SOIL BORINGS CONTAINED LARGER PARTICLES OF GRAVEL AND COBBLES THAT ARE NOT REFLECTED IN THE LABORATORY GRADATION TEST RESULTS SHOWN IN THE LOGS OF EXPLORATIONS.
- UNLESS OTHERWISE NOTED, STANDARD PENETROMETER DATA WERE OBTAINED IN ACCORDANCE WITH ASTM D 1586 USING A STANDARD 457mm (18") LONG BY 51mm (2") O.D. BY 38mm (1-1/2") I.D. SAMPLER. A 64mm (2-1/2") O.D. BY 61mm (2") I.D. SAMPLER OR A 76mm (3") O.D. BY 64mm (2-1/2") I.D. SAMPLER WAS USED IN SOME CASES WHERE COARSE GRAINED MATERIAL WAS ENCOUNTERED. CHANGES IN SAMPLERS ARE DESIGNATED WITH AN ASTERISK (*) AND ARE STATED WITHIN THE DESCRIPTION. THE SPLIT-BARREL PENETROMETER WAS DRIVEN USING AN AUTOMATIC-TRIP, 63.5kg (140-LB.) SAFETY HAMMER. THE FIELD SPT "N" VALUES HAVE NOT BEEN CORRECTED FOR SPOON SIZE OR DEPTH.
- GROUNDWATER WAS ENCOUNTERED AT THE TIME OF EXPLORATIONS; GROUNDWATER LEVELS CAN BE EXPECTED TO FLUCTUATE IN RESPONSE TO RAINFALL VARIATIONS, PARTICULARLY IN THE VICINITY OF SITE DRAINAGE FEATURES.
- DEPENDING ON THE SOIL MOISTURE AT THE TIME OF CONSTRUCTION, THE SOIL ENCOUNTERED MAY BE UNSTABLE OR POTENTIALLY UNSTABLE. THE PROBABILITY OF UNSTABLE CONDITIONS IS HIGHEST WHEN THE SOIL MOISTURE IS GREATEST.
- REFUSAL WITH THE STANDARD PENETROMETER IS DEFINED AS ONE OF THE FOLLOWING:
A. 10 BLOWS FOR NO APPARENT ADVANCEMENT OF THE SAMPLER; OR
B. 50 BLOWS FOR LESS THAN 152mm (6") ADVANCEMENT OF THE SAMPLER; OR
C. 100 BLOWS FOR 152mm (6") TO 457mm (18") ADVANCEMENT OF THE SAMPLER.
- ATTEMPT WITH THE STANDARD PENETROMETER IS DEFINED AS REFUSAL WITHIN THE FIRST 152mm (6") OF SEATING PENETRATION.
- SEE SHEET C-100 FOR LOCATION OF EXPLORATIONS.

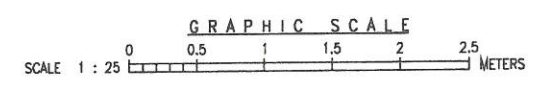

AS BUILT

2 F - 9 7 - 1 3
SITE R4

DEPTH	N	GR	SA	FI	LL	PI	MC	SM	NP	N	N*	R	A	W	B.O.H.
EL. 13.65m (44.8')= 0															
(5.0') 1.5m	22														
(6.5') 2.0m	10	5	37	58											
(7.0') 2.1m															
(9.0') 2.7m	13														
(11.0') 3.4m															
(13.0') 4.0m															
(15.0') 4.6m	27														
(16.5') 5.0m	27	0	38	62											
(17.0') 5.2m															
(20.5') 6.2m	23														
(27.5') 8.4m	13	0	85	15											
(29.0') 8.8m															
(31.0') 9.4m	11														
(40.0') 12.2m	27														

(Continued in Next Column)

2 F - 9 7 - 1 3
(Continued from Previous Column)

DEPTH	N	GR	SA	FI	LL	PI	MC	SM	NP	N	N*	R	A	W	B.O.H.
(40.0') 12.2m	8														
(41.5') 12.6m	9														
(45.0') 13.7m															
(46.5') 14.2m	2	5	85	10											
(48.5') 14.8m	38														
(52.0') 15.8m	30*	31	30	39	26	8	8								
(53.5') 16.3m															
(55.5') 16.9m	100*														
(59.0') 18.0m	60*	28	32	40											
(60.5') 18.4m															
(62.5') 19.1m	110*	38	49	13											
(64.0') 19.6m															
(66.0') 20.1m	50*														
(68.5') 20.9m	78*	1	88	11											
(70.0') 21.3m															

B.O.H.

SITE R4

SITE R4

Boring drilled on waterside of levee

DEPTH		SITE R4							
El. 10.92m (35.8') ± 0		N	GR	SA	FI	LL	PI	MC	Boring drilled on waterside of levee
		-	-	-	-	-	-	-	
		7	0	35	65	-	-	-	<u>SANDY SILT, ML:</u> Firm; moist; brown; fine sand
		14							At 1.8m (6.0') becomes firm
		ML							
		16							At 2.6m (8.5') grades to dark brown
			-	-	-	-	-	-	
		16							At 4.0m (13.0') grades to light reddish-brown
		9							At 4.7m (15.5') grades to brown; fine to medium grained
(18.0')	5.5m								
		11	0	85	15	-	-	-	<u>SILTY SAND, SM:</u> Firm; moist; gray-brown to red-brown; fine to (predominantly) medium grained sand
		7							At (21.5') 6.5m grades to loose; brown
		SM							
		4	-	-	-	-	-	-	From 7.5m (24.5') grades moist to wet
		6							
(30.0')	9.1m								<u>POORLY GRADED SAND WITH SILT, SP-SM:</u>
≡ (31.0')	9.4m	SP-SM	9	7	85	8	-	-	Loose; moist; brown; fine to medium grained sand
									At 9.1m (30.0') Wet; trace of coarse sand
(33.0')	10.1m								
		R							
		R							At 11.3m (37.0') changed drill rigs to ODEX
(39')	11.9m								

(CONTINUED IN THE NEXT COLUMN)

(CONTINUED FROM PREVIOUS COLUMN)

(CONTINUED FROM PREVIOUS COLUMN)

DEPTH		(CONTINUED FROM PREVIOUS COLUMN)							
(39')	11.9m		N	GR	SA	FI	LL	PI	MC
		GRAVEL AND COBBLES	-	-	-	-	-	-	-
(47.0')	14.3m	ML	-	-	-	-	-	-	-
			CLAYEY SILT, ML: Very stiff; moist; tan At 14.6m (48.0') changed drill rigs to Mobile						
(50.0')	15.2m	SM	34						
			-	-	-	-	-	-	-
			27						
			SILTY SAND, SM: Dense; wet; brown; fine to medium grained sand; abundant mica At 16.1m (53.0') grades to very firm						
(56.0')	17.1m	SP-SM	37	0	92	8	-	-	-
			POORLY GRADED SAND WITH SILT, SP-SM: Dense; wet; gray; fine to medium grained sand; abundant mica; decreased silt content						
(59.5')	18.1m	ML	51						
			-	-	-	-	-	-	-
(62.0')	18.9m	SM	14						
			SILTY SAND, SM: Firm; wet; gray-brown; fine to medium grained sand						
(63.5')	19.3m	ML	20	0	16	84	42	8	-
			SANDY SILT, ML: Firm; moist; red-brown; fine grained sand At 20.3m (66.5') grades to mottled light gray with orange						
			56						
			At 20.7m (68.0') very dense; grades to brown						
			21						
			At 21.8m (71.5') firm						
			45						
			At 23.0m (75.5') Dense; grades to mottled gray; weak cementation						
(77.0')	23.5m								

(CONTINUED IN THE NEXT COLUMN)

(CONTINUED FROM PREVIOUS COLUMN)

(CONTINUED FROM PREVIOUS COLUMN)

DEPTH		(CONTINUED FROM PREVIOUS COLUMN)								
		N	GR	SA	FI	LL	PI	MC		
(77.0')	23.5m	SM	63						<u>SILTY SAND, SM:</u> Very dense; wet; gray-brown; fine grained sand At 24.5m (80.5') grades from fine to medium grained sand; weak cementation; trace of clay	
			76							
(83.2')	25.4m	ML	57						<u>SILT WITH SAND, ML:</u> Very dense; moist; gray with mottled orange; fine grained sand	
			R							
			68							
(90.4')	27.5m	SM							<u>SILTY SAND, SM:</u> Very dense; wet; gray; fine to medium grained sand	
(91.0')	27.7m									
B.O.H.										
Boring drilled 25-26 Feb. 03										


LEGEND:

- | | |
|--------|--|
| GR | GRAVEL, PERCENT BY WEIGHT PASSING THE 76mm (3-INCH) SIEVE AND RETAINED ON THE NO. 4 SIEVE. |
| SA | SAND, PERCENT BY WEIGHT PASSING THE NO. 4 SIEVE AND RETAINED ON THE NO. 200 SIEVE. |
| FI | FINES, PERCENT BY WEIGHT PASSING THE NO. 200 SIEVE. |
| LL | LIQUID LIMIT. |
| PI | PLASTICITY INDEX (LIQUID LIMIT MINUS PLASTIC LIMIT). |
| MC | LABORATORY DETERMINED MOISTURE CONTENT IN PERCENT OF DRY WEIGHT. |
| SM | COMBINED FIELD VISUAL IDENTIFICATION AND/OR LABORATORY CLASSIFICATION. |
| NP | NONPLASTIC. |
| N | NUMBER OF BLOWS WITH THE STANDARD PENETROMETER. |
| R | REFUSAL WITH THE STANDARD PENETROMETER (SEE NOTE 9). |
| A | ATTEMPT WITH THE STANDARD PENETROMETER (SEE NOTE 10). |
| W | WATER LEVEL. |
| B.O.H. | BOTTOM OF HOLE. |

NOTES:

1. THIS DRAWING IS TO BE USED ONLY FOR APPROXIMATE DESCRIPTIONS OF SUBSURFACE CONDITIONS.
2. SOIL CLASSIFICATIONS AND DESCRIPTIONS ARE BASED ON FIELD LOG DESCRIPTIONS IN ACCORDANCE WITH ASTM D 2488 (DESCRIPTION AND IDENTIFICATION OF SOILS, VISUAL-MANUAL PROCEDURE) AND/OR LABORATORY TEST RESULTS IN ACCORDANCE WITH ASTM D 2487 (CLASSIFICATION OF SOILS FOR ENGINEERING PURPOSES).
3. ALL COLORS SHOWN ARE IN ACCORDANCE WITH THE MUNSELL SOIL COLOR CHART.
4. ALL SIEVE SIZES SHOWN ARE METRIC WITH U.S. STANDARD IN PARENTHESES.
5. BORING 2F-03-20 WAS DRILLED WITH A MOBILE B-61 DRILL RIG USING A 203mm (8") HOLLOW STEM AUGER BETWEEN 25 AND 26 FEBRUARY 2003.
6. STANDARD PENETROMETER DATA WERE OBTAINED IN ACCORDANCE WITH ASTM D 1586 UTILIZING A 610mm (24") LONG STANDARD 51mm O.D. BY 35mm I.D. SPLIT BARREL SAMPLER. THE SPLIT-BARREL PENETROMETER WAS DRIVEN USING AN AUTOMATIC-TRIP, 63.5 KG SAFETY HAMMER. ALL SPT "N" VALUES ARE "FIELD", I.E. UNCORRECTED FOR DEPTH.
7. GROUNDWATER WAS ENCOUNTERED AT THE TIME OF EXPLORATIONS; GROUNDWATER LEVELS CAN BE EXPECTED TO FLUCTUATE IN RESPONSE TO RAINFALL VARIATIONS, PARTICULARLY IN THE VICINITY OF SITE DRAINAGE FEATURES.
8. DEPENDING ON THE SOIL MOISTURE AT THE TIME OF CONSTRUCTION, THE SOIL ENCOUNTERED MAY BE UNSTABLE OR POTENTIALLY UNSTABLE. THE PROBABILITY OF UNSTABLE CONDITIONS IS HIGHEST WHEN THE SOIL MOISTURE IS GREATEST.
9. REFUSAL WITH THE STANDARD PENETROMETER IS DEFINED AS ONE OF THE FOLLOWING:
 - A. 10 BLOWS FOR NO APPARENT ADVANCEMENT OF THE SAMPLER; OR
 - B. 50 BLOWS FOR LESS THAN 152mm (6") ADVANCEMENT OF THE SAMPLER; OR
 - C. 100 BLOWS FOR 152mm (6") TO 457mm (18") ADVANCEMENT OF THE SAMPLER.
10. ATTEMPT WITH THE STANDARD PENETROMETER IS DEFINED AS REFUSAL WITHIN THE FIRST 152mm (6") OF SEATING PENETRATION.
11. SEE SHEET C-100 FOR LOCATION OF EXPLORATIONS.
12. SEE SHEET B-703 FOR STANDARD PENETROMETER DESCRIPTIVE DATA.

GRAPHIC SCALE

SCALE 1 : 25  METERS

AS BUILT



US Army Corps
of Engineers
Sacramento District


[illegible]

DEPARTMENT OF THE ARMY CORPS OF ENGINEERS SACRAMENTO, CALIFORNIA	Designed by J. SCARFONE		Date:	Rev.
	Dwn by	Ckd by	Design file no.	
	K. PHAM	R. HANSA	X-XX-XXX	
	Reviewed by		SPEC. No.	
			XXXX	
SACRAMENTO DISTRICT IN-HOUSE DESIGN 1325 J STREET SACRAMENTO, CA 95814-2922	Submitted by		File name:	
	WHF, SD, KCH, SEC. SEC.		PILOT date:	MAY 2007
			PLOT date:	PILOT date: 11

CALIFORNIA
SACRAMENTO COUNTY
AMERICAN RIVER COMMON FEATURES
(REMAINING SITES) WRDA 1996
CONTRACT 1
SITE - R4
LOG OF EXPLORATION
2F-03-20

Sheet
reference
number:

B-704
Sheet 9 of 21

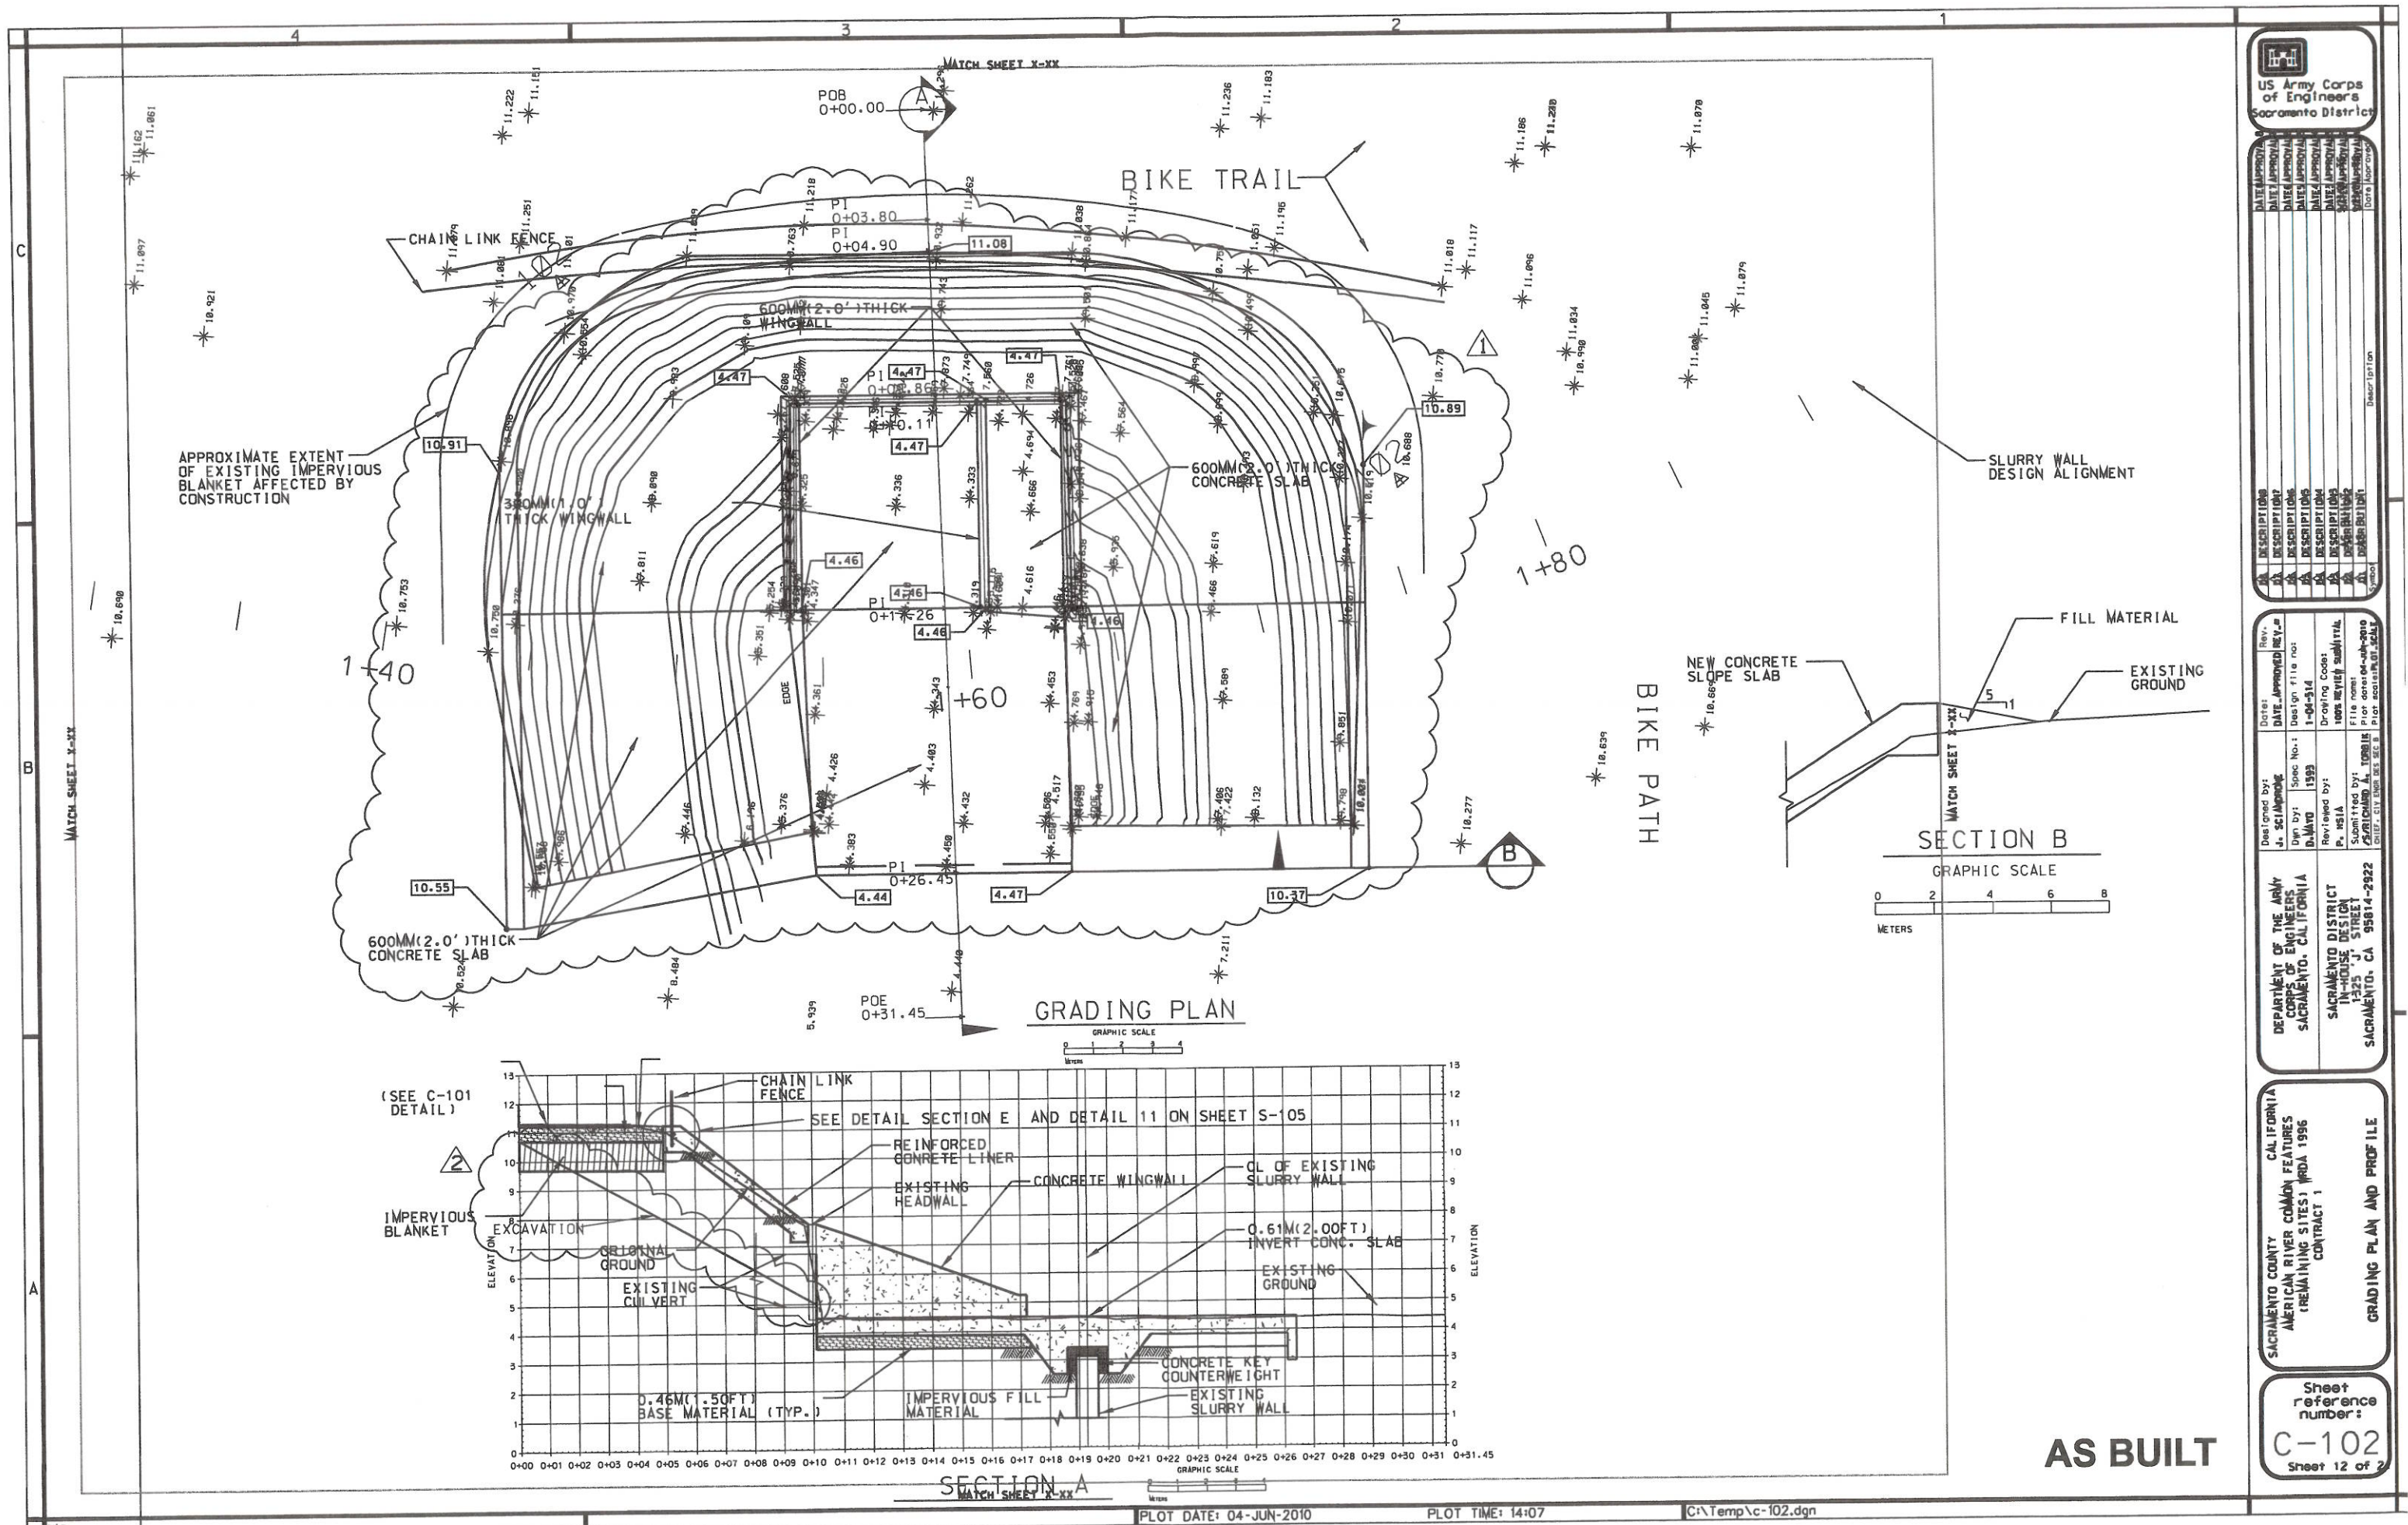

DATE	DESCRIPTION	BY	CHKD	APP'D
11/11/01	DESIGN	J. SCHEIDT		
11/11/01	CHECK	J. SCHEIDT		
11/11/01	DESIGN	J. SCHEIDT		
11/11/01	CHECK	J. SCHEIDT		
DATE	DESCRIPTION	BY	CHKD	APP'D
11/11/01	DESIGN	J. SCHEIDT		
11/11/01	CHECK	J. SCHEIDT		
11/11/01	DESIGN	J. SCHEIDT		
11/11/01	CHECK	J. SCHEIDT		
AS BUILT

Sheet reference number: C-102 Sheet 12 of 2

Rev.	Date	By	Description
1	9/23/08	TS	AS BUILT
2	9/23/08	TS	AS BUILT
3	9/23/08	TS	AS BUILT
4	9/23/08	TS	AS BUILT
5	9/23/08	TS	AS BUILT

Rev.	Date	By	Description
1	9/23/08	TS	AS BUILT
2	9/23/08	TS	AS BUILT
3	9/23/08	TS	AS BUILT
4	9/23/08	TS	AS BUILT
5	9/23/08	TS	AS BUILT


DESIGNED BY: J. SCLANDRONE	DATE: 1-04-514	DESIGN FILE NO: 1-04-514	100% REVIEW SUBMITTAL FILE NO: 1-04-514
DRAWN BY: D. MAYO	1593	REVIEWED BY: P. HSIA	100% REVIEW SUBMITTAL FILE NO: 1-04-514
SUBMITTED BY: CHIEF, CIVIL ENGINEERING SECTION			

SACRAMENTO COUNTY CALIFORNIA AMERICAN RIVER CORPUS FEATURES (REMAINING SITES) WRDA 1996 CONTRACT 1	SACRAMENTO DISTRICT IN-HOUSE DESIGN 1325 "J" STREET SACRAMENTO, CA 95814-2922
--	--


Sheet reference number: C-104 Sheet 14 of 21
--

NOTES:


1. PRIOR TO THE START OF THE TEMPORARY EXCAVATION AND TEMPORARY SHORING INSTALLATION THE LOCATION OF EXISTING SLURRY SHALL BE DETERMINED BY POT-HOLING.
2. POTHOLING SHALL BE PERFORMED IN THE PRESENCE OF THE CONTRACTING OFFICER'S REPRESENTATIVE AND CORPS GEOTECHNICAL ENGINEER FROM THE SOIL DESIGN SECTION.
3. ADJUSTMENTS SHALL BE MADE TO TEMPORARY SHORING AND EXCAVATION LIMITS BASED ON ACTUAL LOCATION OF SLURRY.
4. PRIOR TO EXCAVATION AND SHORING INSTALLATION LOCATION OF UTILITIES SHALL BE IDENTIFIED.
5. REFER TO SPECIFICATION SECTION 35 42 13.00 41 FOR TEMPORARY SHORING REQUIREMENTS.

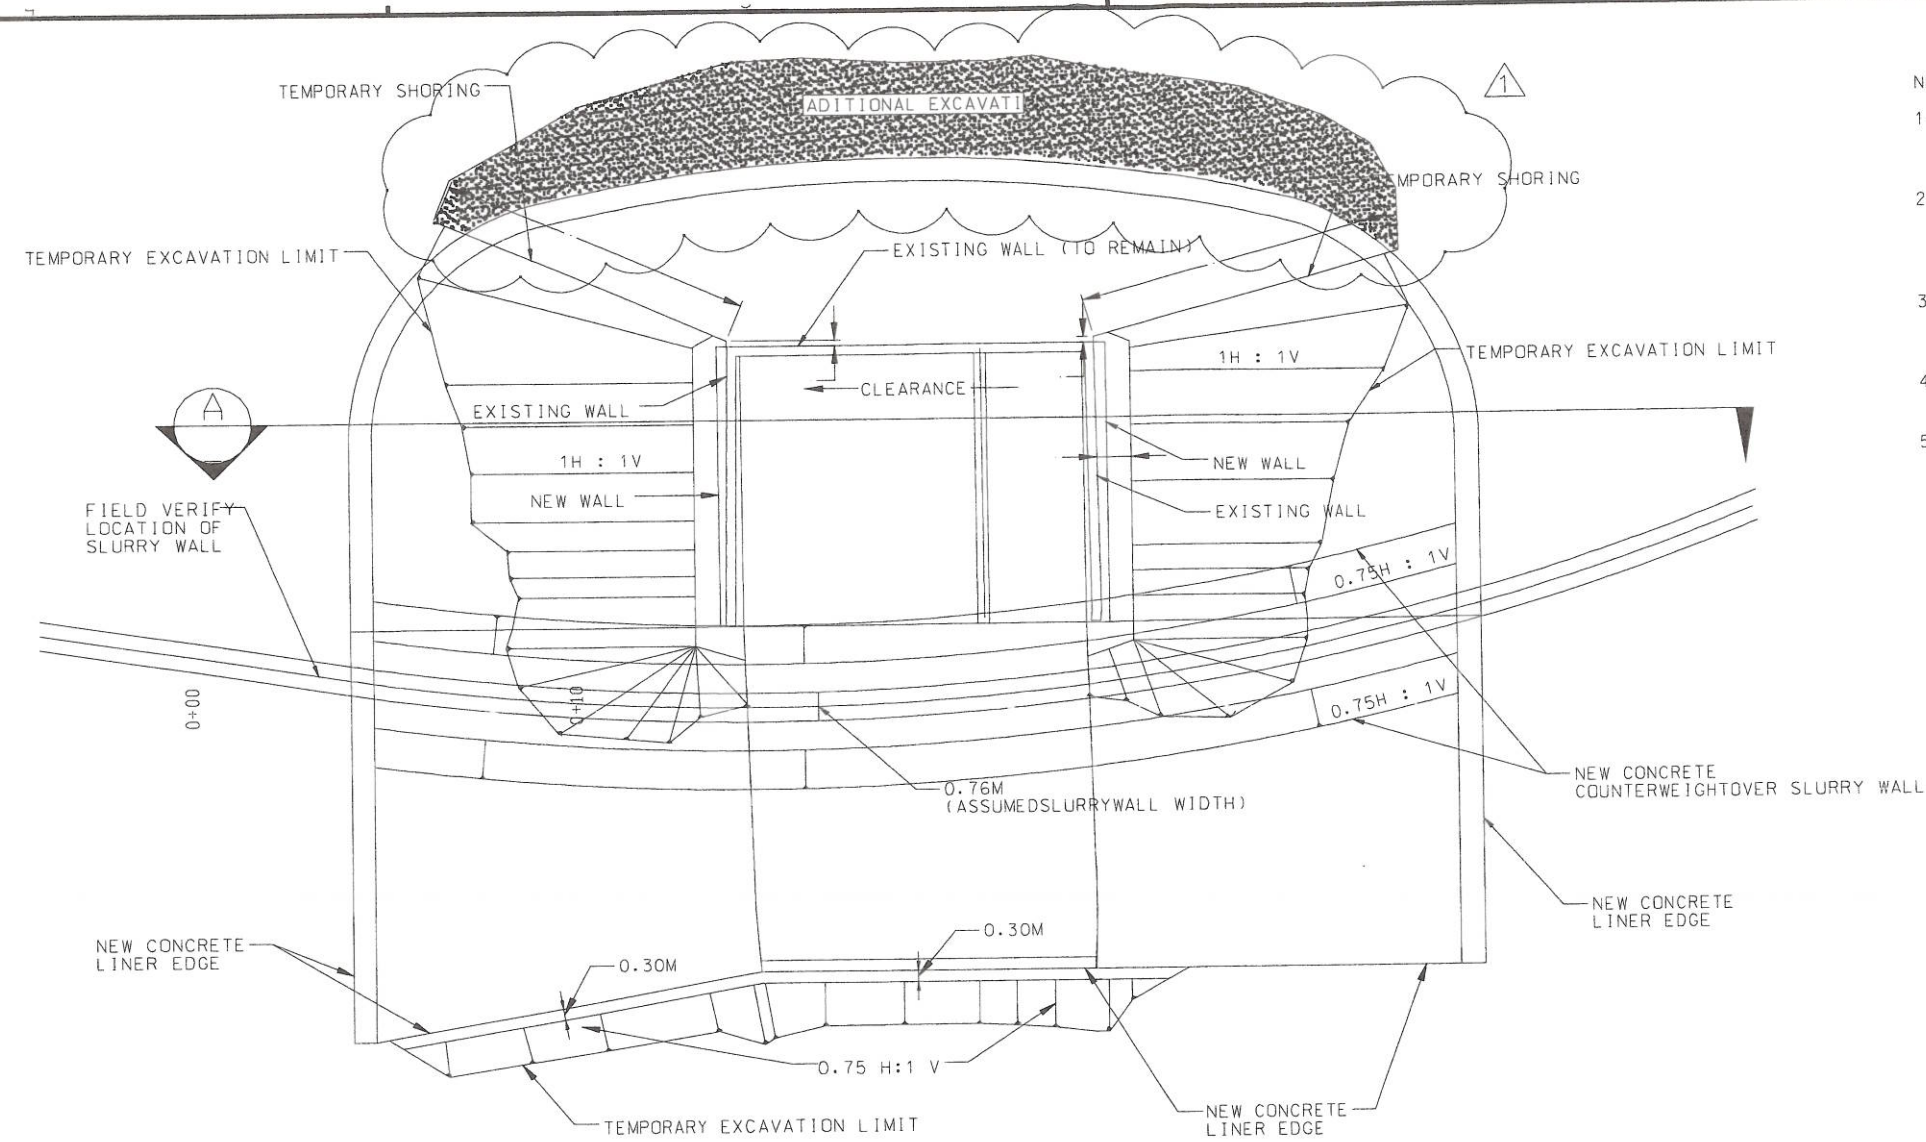


PLAN
SCALE: 1:100

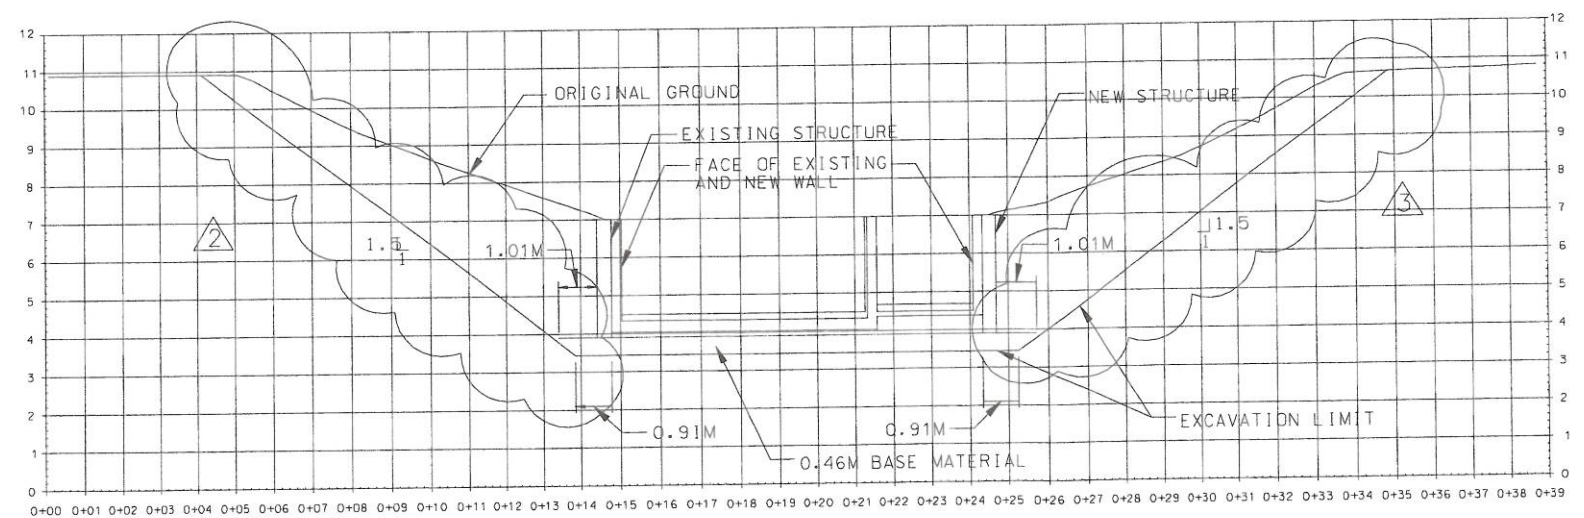


SECTION
SCALE: 1:100

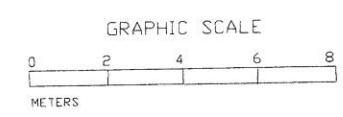


AS BUILT

 

NOTE: NO CONCRETE CAP
EXISTS ON THIS SITE

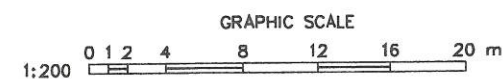

AS BUILT

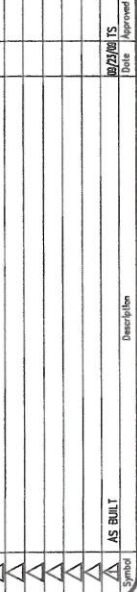



Dwg by: EDM	Spec No.: 1593	Design file no:
Revised by:	Drawing Code: 90% SUBMISSION	File name: Plot date: Plot scale:
Submitted by: /s/ Larry Croffey Chief, American Water Res. Soc.	AS NOTED	

**SACRAMENTO DISTRICT
IN-HOUSE DESIGN
1325 'J' STREET
SACRAMENTO, CA 95814-2922**

AMERICAN RIVER COMMON FEATURES
(REMAINING SITES) IRDA 1996
CONTRACT 1

Sheet
reference
number:
S-102
Sheet 17 of 21

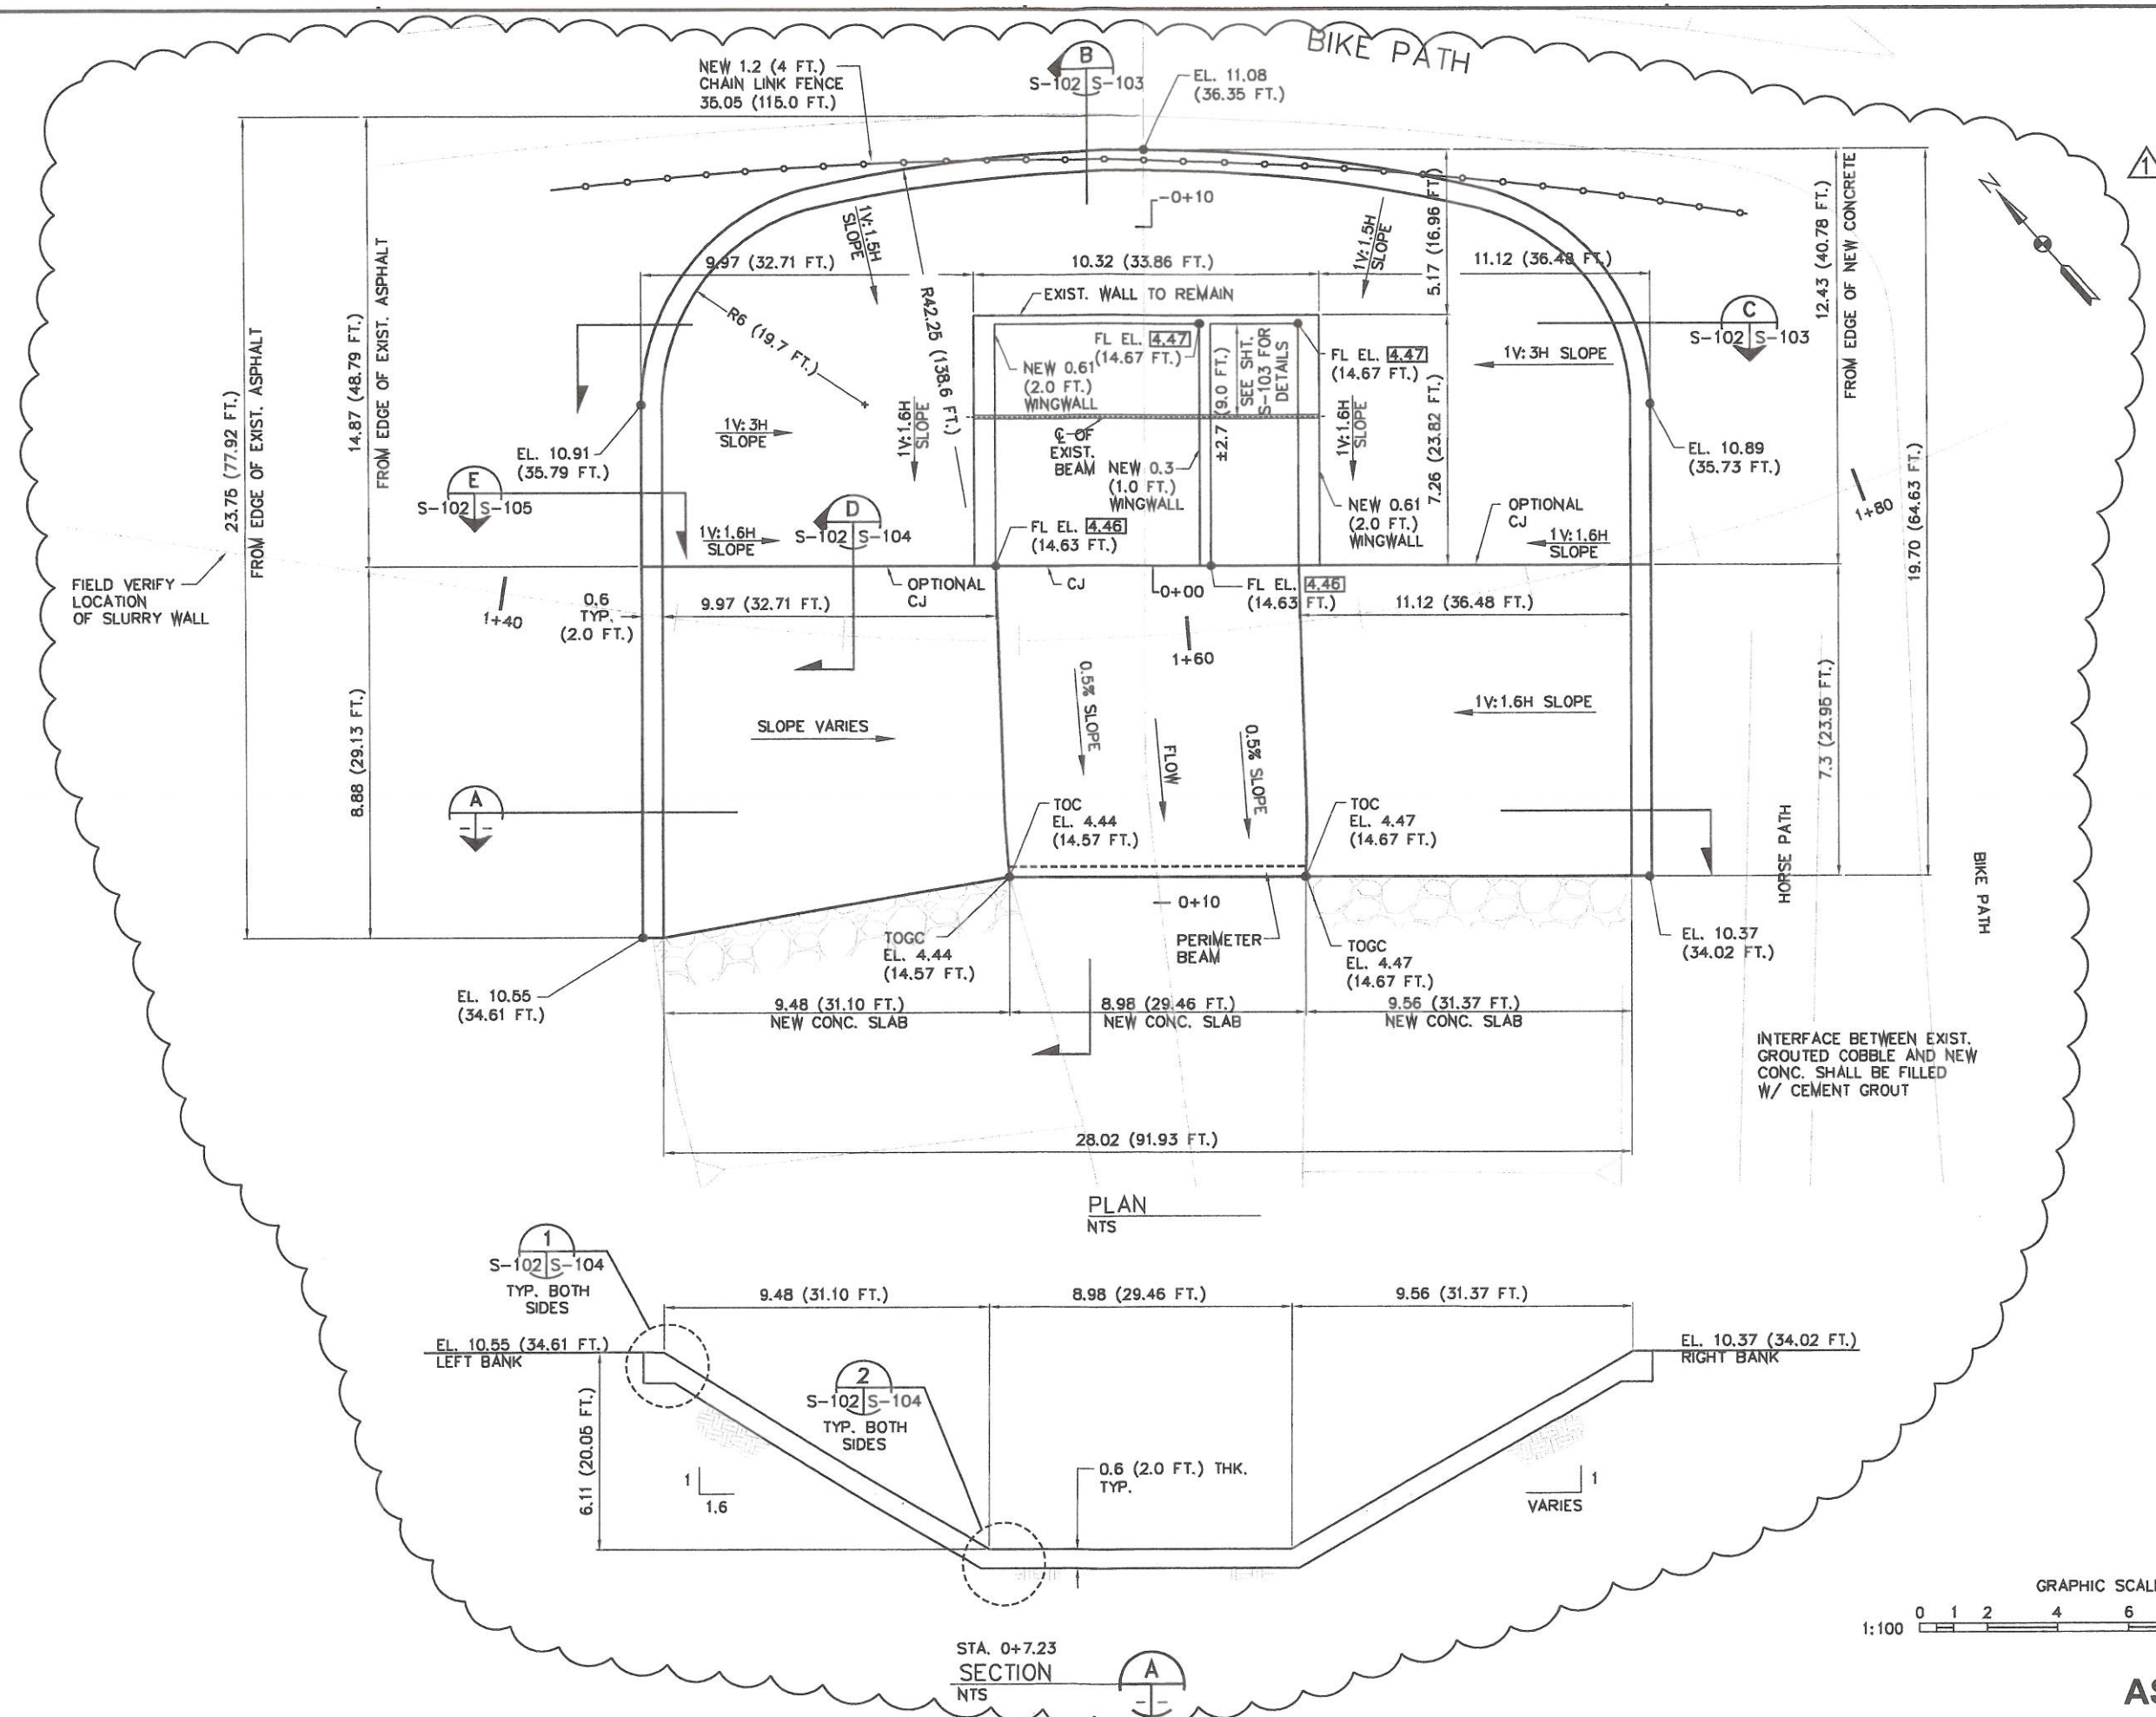

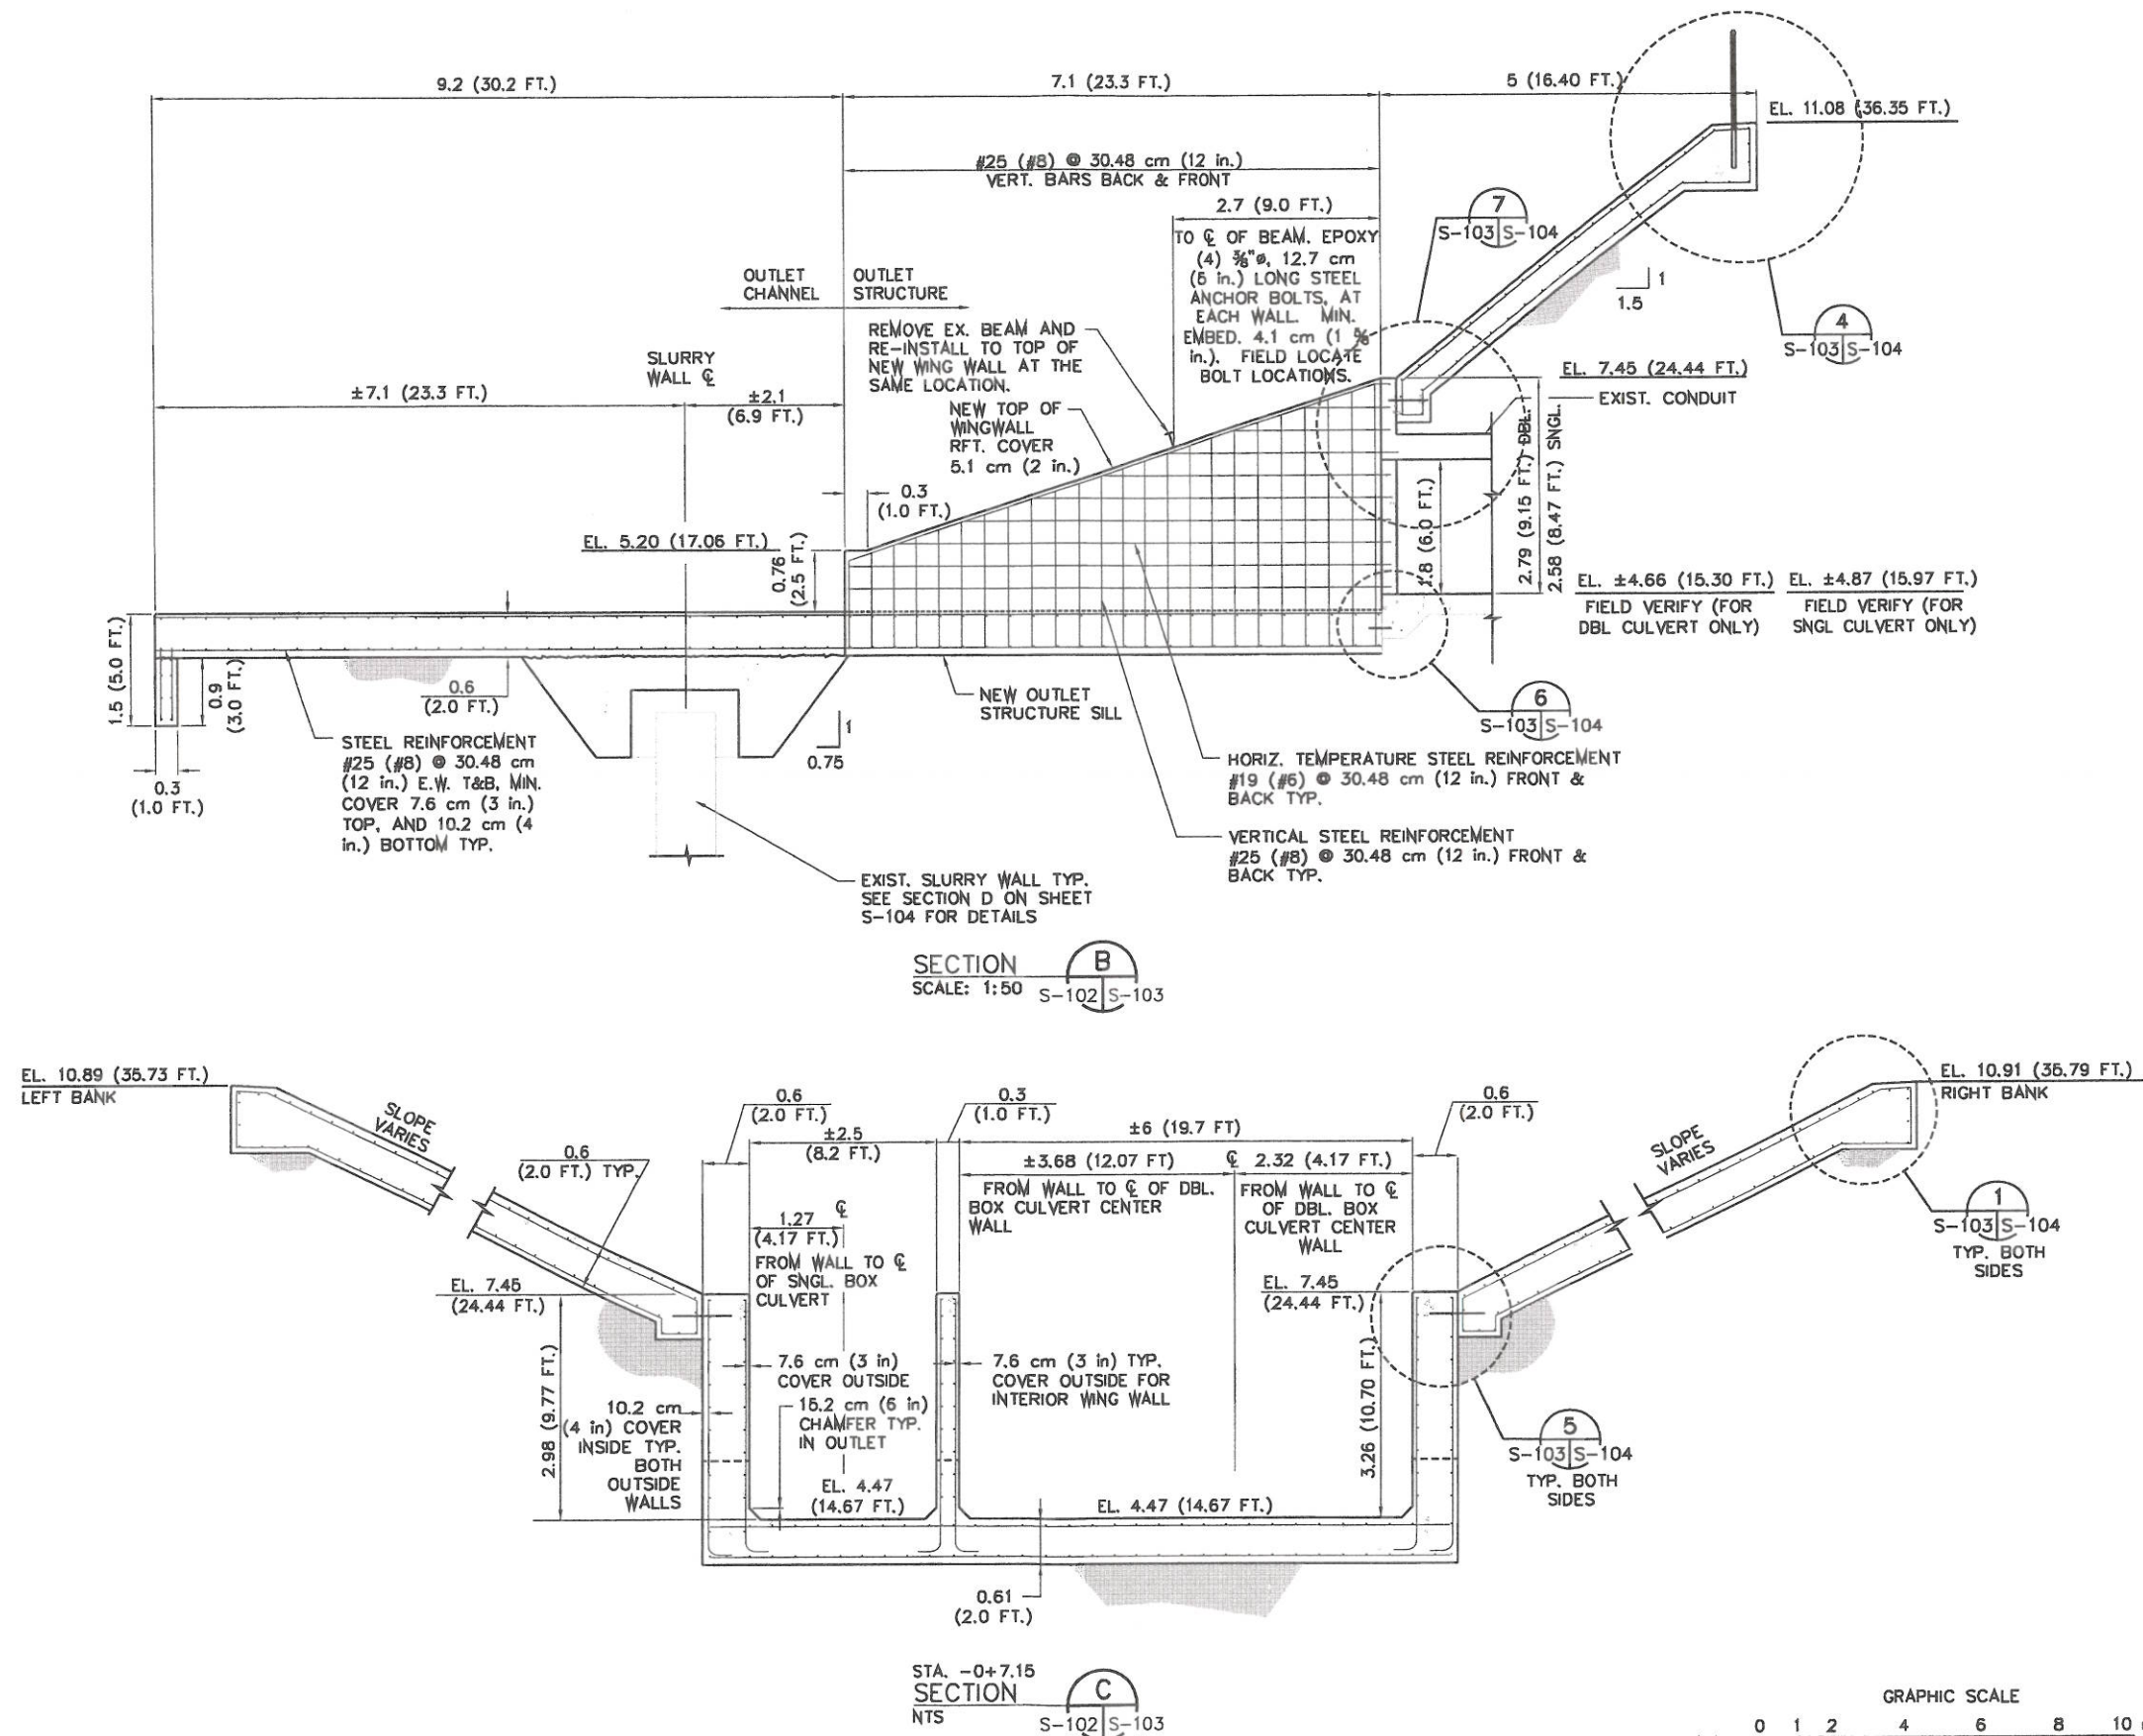

GRAPHIC SCALE

0 1 2 4 6 8 10 m

1:100

AS BUILT

[illegible]



650	Spec No.: 1593	Design file no:
Drawn by: EDM	Reviewed by:	Drawing Code: 90% DIMENSION
Submitted by: /s/ Larry Drayley		File name:
Date: 04/14/2004 09:49:39 AM		Plot date:
Plot by: 04/14/2004 09:49:39 AM		Plot scale:
		AS NOTED

DEPARTMENT OF THE ARMY
CORPS OF ENGINEERS
SACRAMENTO, CALIFORNIA











SACRAMENTO DISTRICT
IN-HOUSE DESIGN
1325 'J' STREET
SACRAMENTO, CA 95814-2922

AMERICAN RIVER
AMERICAN RIVER COMMON FEATURES
(REMAINING SITES) (RDA 1996
CONTRACT 1

Sheet
reference
number:
S-103
Sheet 18 of 21

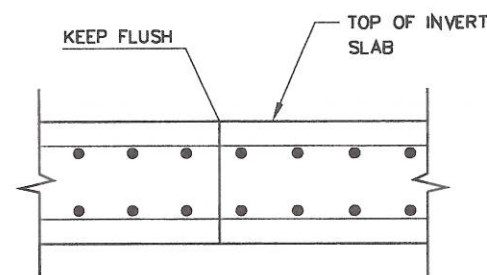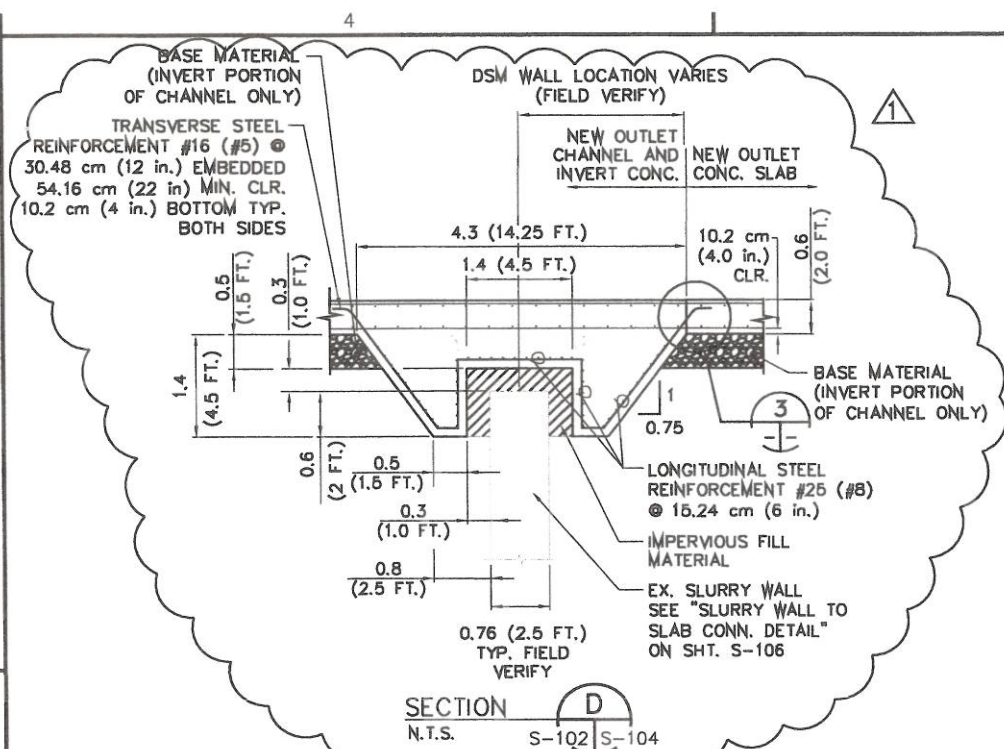

NOTE:
VERTICAL BARS NOT SHOWN

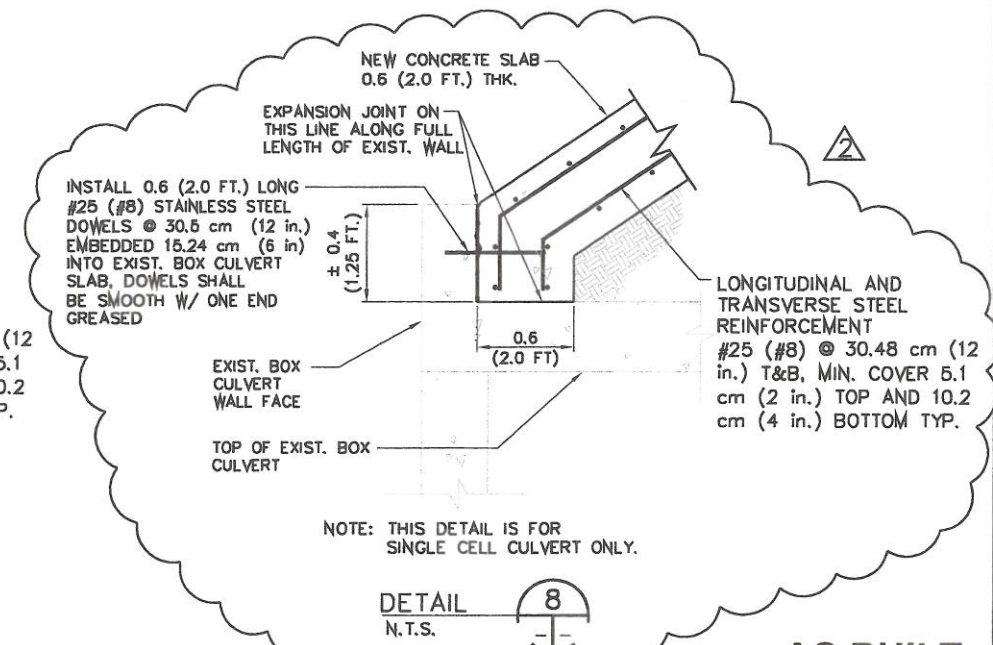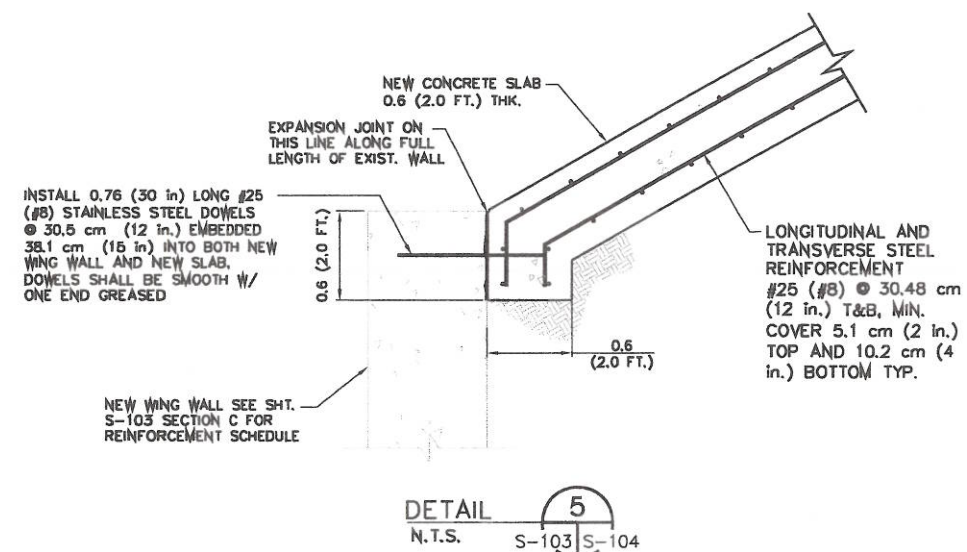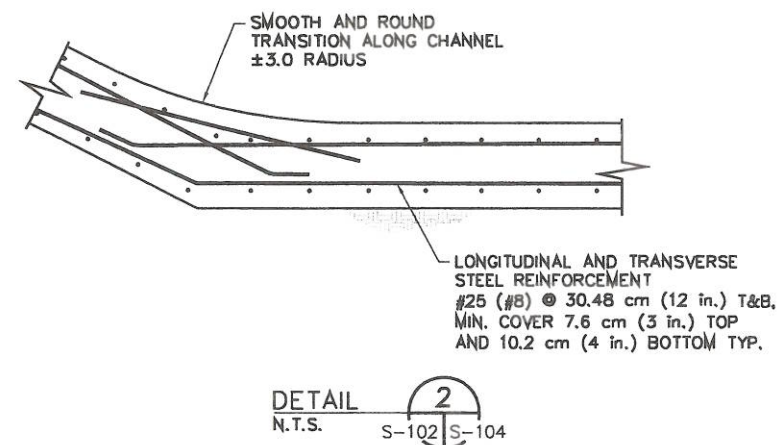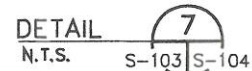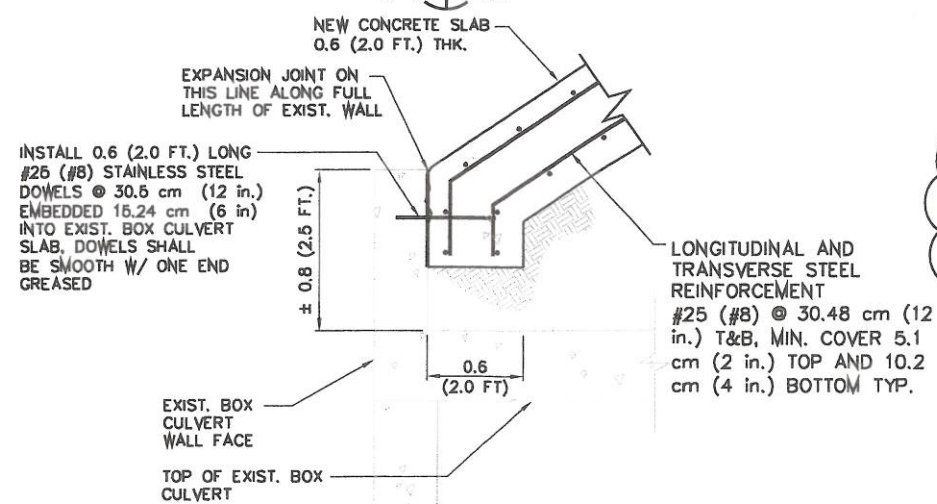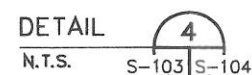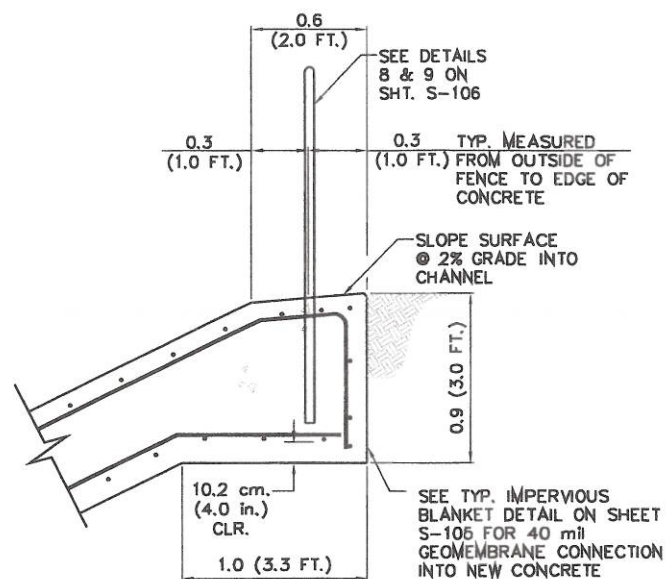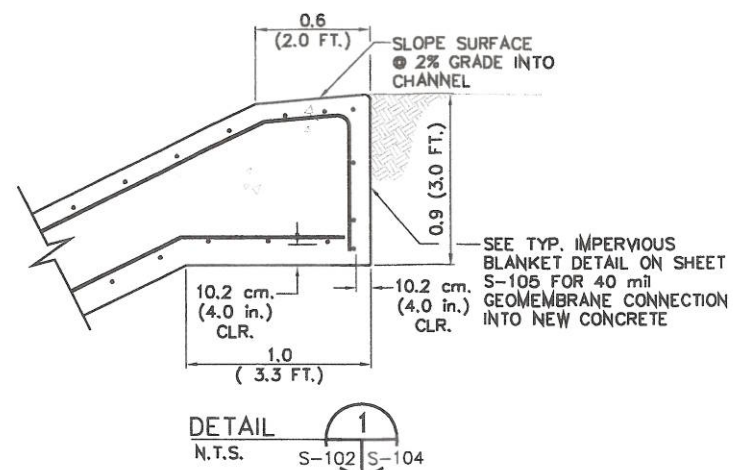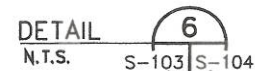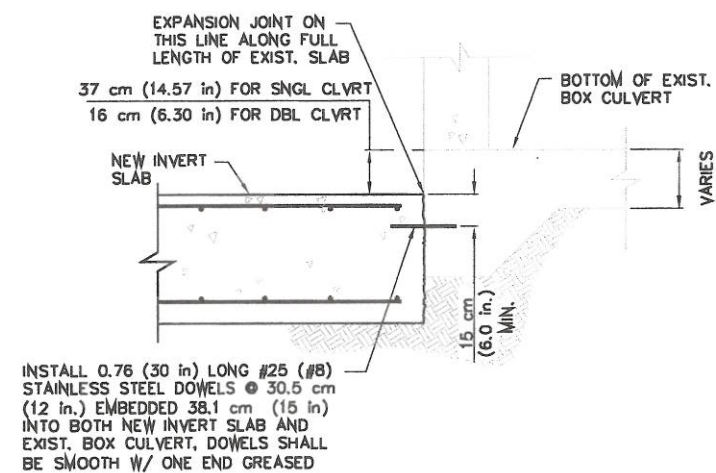

AS BUILT



US Army Corps
of Engineers
Sacramento District

[illegible]

Submitted by:	Spec No.:	Design file no:	Rev.
Desig	1993		
Redesigned by:	Drawing Code:	AS NOTED	
	9005 SUBMISSION		
Submitted by:	File name:		
PL/Lorry Cratley	Plot date:		
Chief, Inspection Major Des. Div.	Dwg scale:		

DEPARTMENT OF THE ARMY
CORPS OF ENGINEERS
SACRAMENTO, CALIFORNIA

SACRAMENTO DISTRICT
IN-HOUSE DESIGN
1325 J STREET
SACRAMENTO, CA 95814-2922

**AMERICAN RIVER
CALIFORNIA**

**AMERICAN RIVER COMMON FEATURES
(REMAINING SITES) MEDIA 1996
CONTRACT 1**


SECTIONS AND DETAILS

Sheet
reference
number:

S-104
Sheet 19 of 21



TYPICAL IMPERVIOUS BLANKET DETAIL @ CONC. FACE
N.T.S.

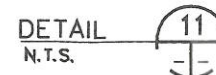

AS BUILT

[illegible]

Designed by	Date	Rev.
SO		
Spec No.:	Design file no:	
1501	1503	
Drawn by		
DN		
Reviewed by	Drawing Code	
	5003 1503/1501	
Submitted by	File name	
1501 / Larry Crisley	Plot date	

DEPARTMENT OF THE ARMY
CORPS OF ENGINEERS
SACRAMENTO, CALIFORNIA

SACRAMENTO DISTRICT
IN-HOUSE DESIGN
1325 'J' STREET
SACRAMENTO, CA 95814-2922

AMERICAN RIVER
CALIFORNIA
AMERICAN RIVER COMMON FEATURES
(REMAINING SITES) IRDA 1996
CONTRACT 1
IMPERVIOUS BLANKET AND
CONNECTION DETAILS


Sheet
reference
number:
S-105
Sheet 20 of 21

4 3 2 1

C


B

A

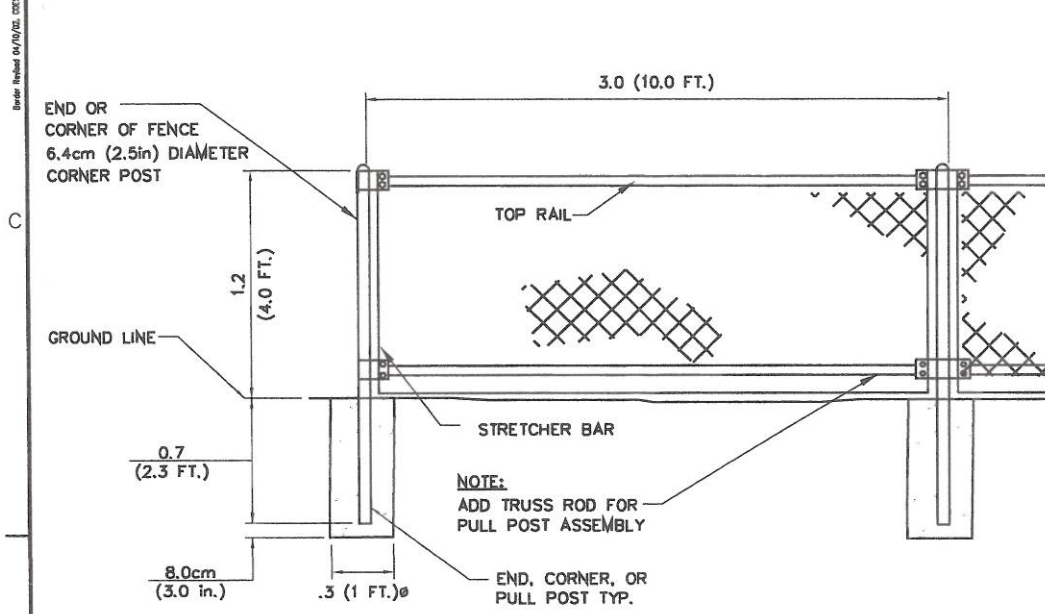


CORNER OR END PANEL ASS'Y
PULL POST ASS'Y SIMILAR (EXCEPT AS INDICATED)

DETAIL 8
N.T.S. S-103 S-104

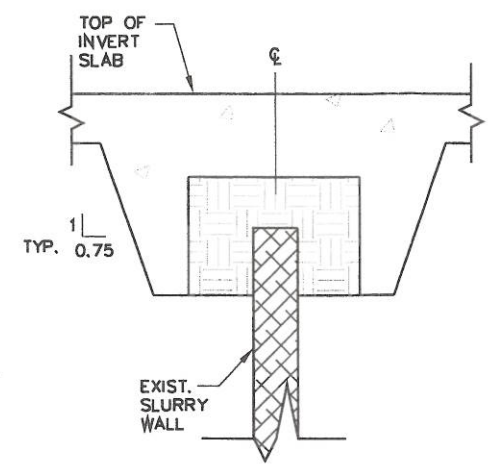


SLURRY WALL TO SLAB CONNECTION DETAIL
(NOT TO SCALE)

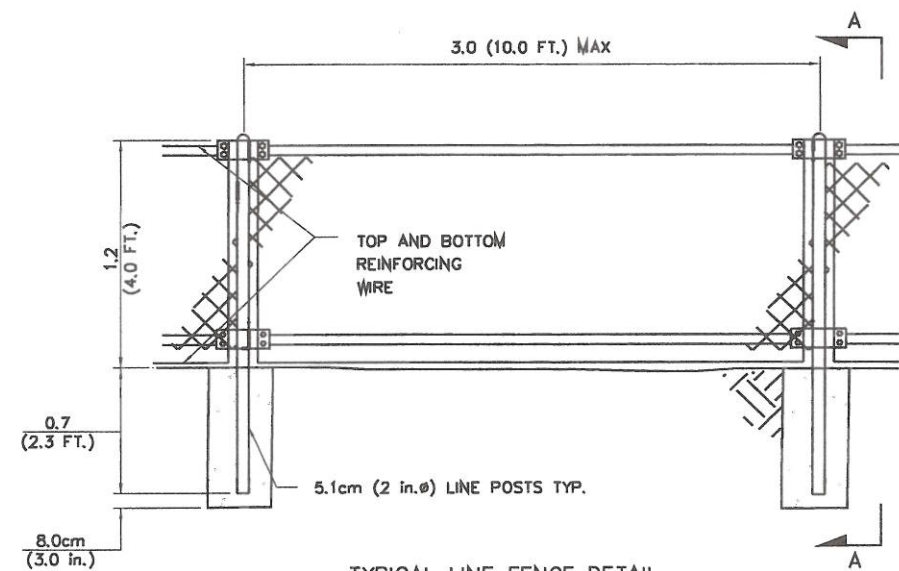

TYPICAL LINE FENCE DETAIL

DETAIL 9
N.T.S. S-103 S-104

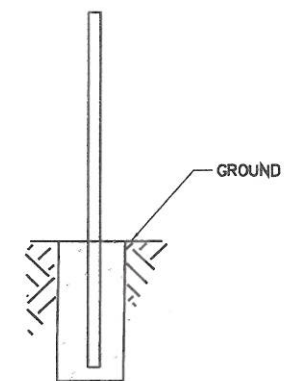

VIEW A-A

GENERAL STRUCTURAL NOTES:

1. CONSTRUCTION: THE CONTRACTOR SHALL BE RESPONSIBLE FOR MAINTAINING THE JOB SITE IN A SAFE CONDITION AND EMPLOYING OSHA APPROVED CONSTRUCTION PRACTICES PERFORMED IN A WORKMANLIKE MANNER. CONTRACTOR SHALL BE SOLELY RESPONSIBLE FOR THE DESIGN OF SHORING, FORMWORK AND OTHER TEMPORARY CONSTRUCTION STRUCTURES. CONSTRUCTION MATERIALS SHALL BE SPREAD OUT TO AVOID OVERLOADING INDIVIDUAL MEMBERS. PERIODIC JOB SITE VISITS BY THE OWNER AND/OR ENGINEER DO NOT CONSTITUTE REVIEW OR APPROVAL OF CONSTRUCTION TECHNIQUES BUT ARE INTENDED SOLELY FOR THE PURPOSE OF CHECKING GENERAL COMPLIANCE OF THE WORK WITH THE PROJECT CONSTRUCTION DOCUMENTS.
2. THE DRAWINGS: THESE DRAWINGS SHALL BE READ AND COORDINATED WITH ALL OTHER CONTRACT DRAWINGS, INCLUDING VENDOR DRAWINGS AND SUBCONTRACTOR SHOP DRAWINGS. SPECIFIC DIMENSIONS, DETAILS AND NOTES SHALL TAKE PRECEDENCE OVER GENERAL NOTES, TYPICAL DETAILS, MINIMUM CODE VALUES OR SCALED INFORMATION ON PLANS OR SECTIONS. ITEMS NOT SPECIFICALLY DETAILED SHALL GENERALLY FOLLOW OTHER SIMILAR DETAILS. DISCREPANCIES, CONFLICTS AND/OR UNCLEAR CONDITIONS SHALL BE BROUGHT TO THE ATTENTION OF THE CONTRACTING OFFICER AND/OR ENGINEER IMMEDIATELY.
3. THE CONTRACTOR SHALL VERIFY ALL CONTROLLING FIELD AND EXISTING CONCRETE DIMENSIONS BEFORE ORDERING OR FABRICATING ANY MATERIAL.
4. ALL FORMED CONCRETE SURFACES SHALL HAVE CLASS "C" FINISH EXCEPT FORMED CONCRETE SURFACES AGAINST WHICH BACKFILL IS PLACED SHALL HAVE CLASS "D" FINISH. SEE SPEC. SECTION 03 30 04.
5. ALL EXPOSED EDGES OF CONCRETE SHALL BE CHAMFERED 19 mm UNLESS OTHERWISE SHOWN.
6. ALL FINISHED SURFACES WHERE A FLOAT OR TROWEL FINISH ARE REQUIRED SHALL HAVE TOOLED EDGES.
7. ALL REINFORCEMENT SPLICES, UNLESS OTHERWISE NOTED, SHALL CONFORM TO CLASS "B" SPLICE FOR $f_c = 35 \text{ MPa}$ (5000 psi), AS SHOWN BELOW:

DEVELOPMENT LENGTH SCHEDULE		
Bar Size	Id (Metric (English))	Splice (Metric (English))
#25 (#8)	87cm (34in)	112cm (44in)
#19 (#6)	65cm (26in)	85cm (33in)
#16 (#5)	55cm (22in)	71cm (28in)

8. ALL BENDS AND HOOKS SHALL BE "STANDARD BENDS AND HOOKS" AS DETAILED IN ACI 318M-05.
9. UNLESS OTHERWISE SHOWN, STAGGER SPLICES IN ALTERNATE LONGITUDINAL SLAB REINFORCEMENT AT LEAST 1.2 METERS.

MATERIAL NOTES:

1. CONCRETE SHALL HAVE A MINIMUM COMPRESSIVE STRENGTH OF 35 MPa (5000 psi) AT 28 DAYS (ACI 318M-05).
2. REINFORCING STEEL SHALL HAVE A MINIMUM YIELD STRENGTH OF 420 MPa (60 ksi) UNLESS NOTED OTHERWISE, AND SHALL CONFORM TO ASTM A 615. SEE SPECIFICATION SECTION 03 30 04.
3. ALL DOWELS SHALL BE STAINLESS STEEL BARS CONFORMING TO ASTM A615, UNLESS NOTED OTHERWISE.
4. ALL STRUCTURAL STEEL SHALL CONFORM TO ASTM SPECIFICATION A-36. UNLESS NOTED OTHERWISE.



Rev.	Date	Description	AS BUILT
1	09/23/08	IS	

Designed by: JSD	Spec. No.: 1593	Drawing Code: 908 SUBMISSION	File name: S-106.dwg	Plot date: 09/23/08
Drawn by: C.K.	Reviewed by: J.A. Leary	Submitted by: J.A. Leary	Checked by: J.A. Leary	Designated by: JSD

DEPARTMENT OF THE ARMY CORPS OF ENGINEERS SACRAMENTO, CALIFORNIA	SACRAMENTO DISTRICT IN-HOUSE DESIGN SACRAMENTO, CA 95814-2922
--	---

CALIFORNIA AMERICAN RIVER COMMON FEATURES (COMMON FEATURES) JMDA 1996	GENERAL STRUCTURAL NOTES AND DETAILS
---	---

Sheet
reference
number:
S-106
Sheet 21 of 21

AS BUILT



January 19, 2011

Kent Zenobia
Department of Water Resources
Department of Flood Management
Project Delivery Branch - CVFPB/USACE Projects 3310 El Camino Avenue, Room 180
Sacramento, CA 95821

**SUBJECT: AMERICAN RIVER COMMON FEATURES PROGRAM
REMAINING SITES – SITE R4:**

Dear Mr. Zenobia:

The U.S. Army Corps of Engineers recently reconstructed the outlet works of the gravity drains at the R4 site near Cal Expo. Representatives of the Sacramento Area Flood Control Agency (SAFCA) reviewed the design, visiting the site during construction and have reviewed the as-built plans and Operation and Maintenance (O&M) Manual.

We find the project to be acceptable to SAFCA and we are agreeable to accepting O&M responsibility for the site.

If you have any questions, please contact me at (916) 874-8737.

Sincerely,

A handwritten signature in blue ink, reading "Richard M. Johnson".

Richard M. Johnson
Interim Executive Director
Sacramento Area Flood Control Agency

cc: Tim Kerr, ARFCD
Grant Kreinberg, SAFCA

Attachment F- Written Notice of Acceptance
of Completed Work



DEPARTMENT OF THE ARMY

SACRAMENTO DISTRICT, CORPS OF ENGINEERS
VALLEY RESIDENT OFFICE
2021 Jefferson Boulevard
West Sacramento, California 95691

April 30, 2010

C-0006

Contract No. W91238-09-D-0020, T.O. 0001 Repair Channel Outlet Structure
R4, Sacramento, California

Subject: "Beneficial Occupancy of Repair Channel Outlet Structure R4"

RDA Contracting, Inc.
2900 Main Street, Ste. 208
Alameda, CA 94501

Gentlemen,

Construction of the Repair Channel Outlet Structure R4 project was
accepted by USACE on September 1, 2009 without any outstanding deficiencies.
Per our letter number C-0005 (dated April 30, 2010) all SWPPP obligations have
been met and are considered terminated.

This is to inform you that, in the event it should become necessary to
implement any of the warranty clauses of this contract, the Government will notify
you. A prompt reply is expected to any request for repairs necessary under the
warranty provisions of your contract.

Sincerely,

Cathy Wise, P.E., CCM
Administrative Contracting Officer

cc:
Contr Div
Con-ops Div
PM - John Hoge
Reading File
File

(415-10c)
GES/ges

WISE CW

CENTRAL VALLEY FLOOD PROTECTION BOARD

3310 El Camino Ave., Rm. 151
SACRAMENTO, CA 95821
(916) 574-0609 FAX: (916) 574-0682
PERMITS: (916) 574-0685 FAX: (916) 574-0682



January 28, 2011

Colonel William J. Leady
District Engineer
Sacramento District
U.S. Army Corps of Engineers
1325 J Street
Sacramento, California 95814-2922

Dear Colonel Leady,

In your July 1, 2010 letter to the Central Valley Flood Protection Board (Board), the U.S. Army Corps of Engineers transferred the recently completed portion of work (R4) of the American River Common Features Project to the Board, performed under the authority of the Water Resources Development Act of 1996 (WRDA 1996). Site R4 is located approximately 250 feet south of the Strong Ranch Slough Pump Station. You advised us that the work meets the requirements of the existing Operation and Maintenance Manual, American River – Part No. 1, Levee Construction from Carmichael Bluffs Downstream 8.3 miles. We understand that the work was completed in accordance with the original plans and specifications. We acknowledge receipt of As-Built Drawings and will forward a copy to the Sacramento Area Flood Control Agency (SAFCA). We acknowledge that the Corps has provided additions and revisions to the existing Operation and Maintenance Manual and that these additions and revisions are to be incorporated into our copies of the Operation and Maintenance Manual.

The Board, on behalf of the State of California, accepted the completed portion of work at its January 28, 2011 meeting and transferred the operation, maintenance, repair, replacement, and rehabilitation of Site R4 work to SAFCA.

If you have any questions, you may contact Kent Zenobia, Project Delivery Branch Chief, at (916) 574-2639.

Sincerely,

Jay Punia
Chief Executive Officer

cc: (Please see attached list of cc's)

Colonel William J. Leady

January 28, 2010

Page 2 of 2

cc: Mr. Randy Olsen, Chief
Readiness Branch
Sacramento District
U.S. Army Corps of Engineers
1325 J Street
Sacramento, California 95814-2922

Mr. Richard Johnson, Interim Executive Director
Sacramento Area Flood District
1007 7th Street
Sacramento, California 95814

CENTRAL VALLEY FLOOD PROTECTION BOARD

3310 El Camino Ave., Rm. 151
SACRAMENTO, CA 95821
(916) 574-0609 FAX: (916) 574-0682
PERMITS: (916) 574-0685 FAX: (916) 574-0682



January 28, 2011

Mr. Richard Johnson
Interim Executive Director
Sacramento Area Flood Control District
1007 7th Street
Sacramento, California 95814

Dear Mr. Johnson,

The U.S. Army Corps of Engineers (USACE) has recently completed the portion of work (R4) of the American River Common Features Project, performed under the authority of the Water Resources Development Act of 1996 (WRDA 1996). Richard Johnson, Interim Executive Director for the Sacramento Area Flood Control District (SAFCA) sent a letter dated January 19, 2011 to Kent Zenobia, Department of Water Resources, Project Delivery Branch Chief, which provided assurance of acceptance for the completed portion of work. The USACE has transferred the completed portion to the State of California for operation and maintenance (see enclosed letter). At its January 28, 2011 meeting, on behalf of the State of California, The Central Valley Flood Protection Board accepted the completed portion of work.

The Board hereby transfers the completed portion of work (R4) of the American River Common Features Project to SAFCA for operation, maintenance, repair, replacement, and rehabilitation. The USACE has advised the Board that the completed portion of work meets the requirements of the existing Operation and Maintenance Manual, American River – Part No. 1, Levee Construction from Carmichael Bluffs Downstream 8.3 miles. The USACE has provided additions and revisions to the existing O&M Manual and that these additions and revisions are to be incorporated into your copies of the Operation and Maintenance Manual. SAFCA will perform operation and maintenance in accordance with the amended Operation and Maintenance Manual. As-Built Drawings are enclosed.

If you have any questions, you may contact Kent Zenobia, Project Delivery Branch Chief, at (916) 574-2639.

Sincerely,

Jay S. Punia
Chief Executive Officer

cc: (Please see attached list)

Mr. Richard Johnson
January 28, 2011
Page 2

cc: Colonel William J. Leady, P.E.
District Engineer
Sacramento District
U.S. Army Corps of Engineers
1325 J Street
Sacramento, California 95814-2922

Mr. Randy Olsen, Chief Readiness Section
Sacramento District
U.S. Army Corps of Engineers
1325 J Street
Sacramento, California 95814-2922